



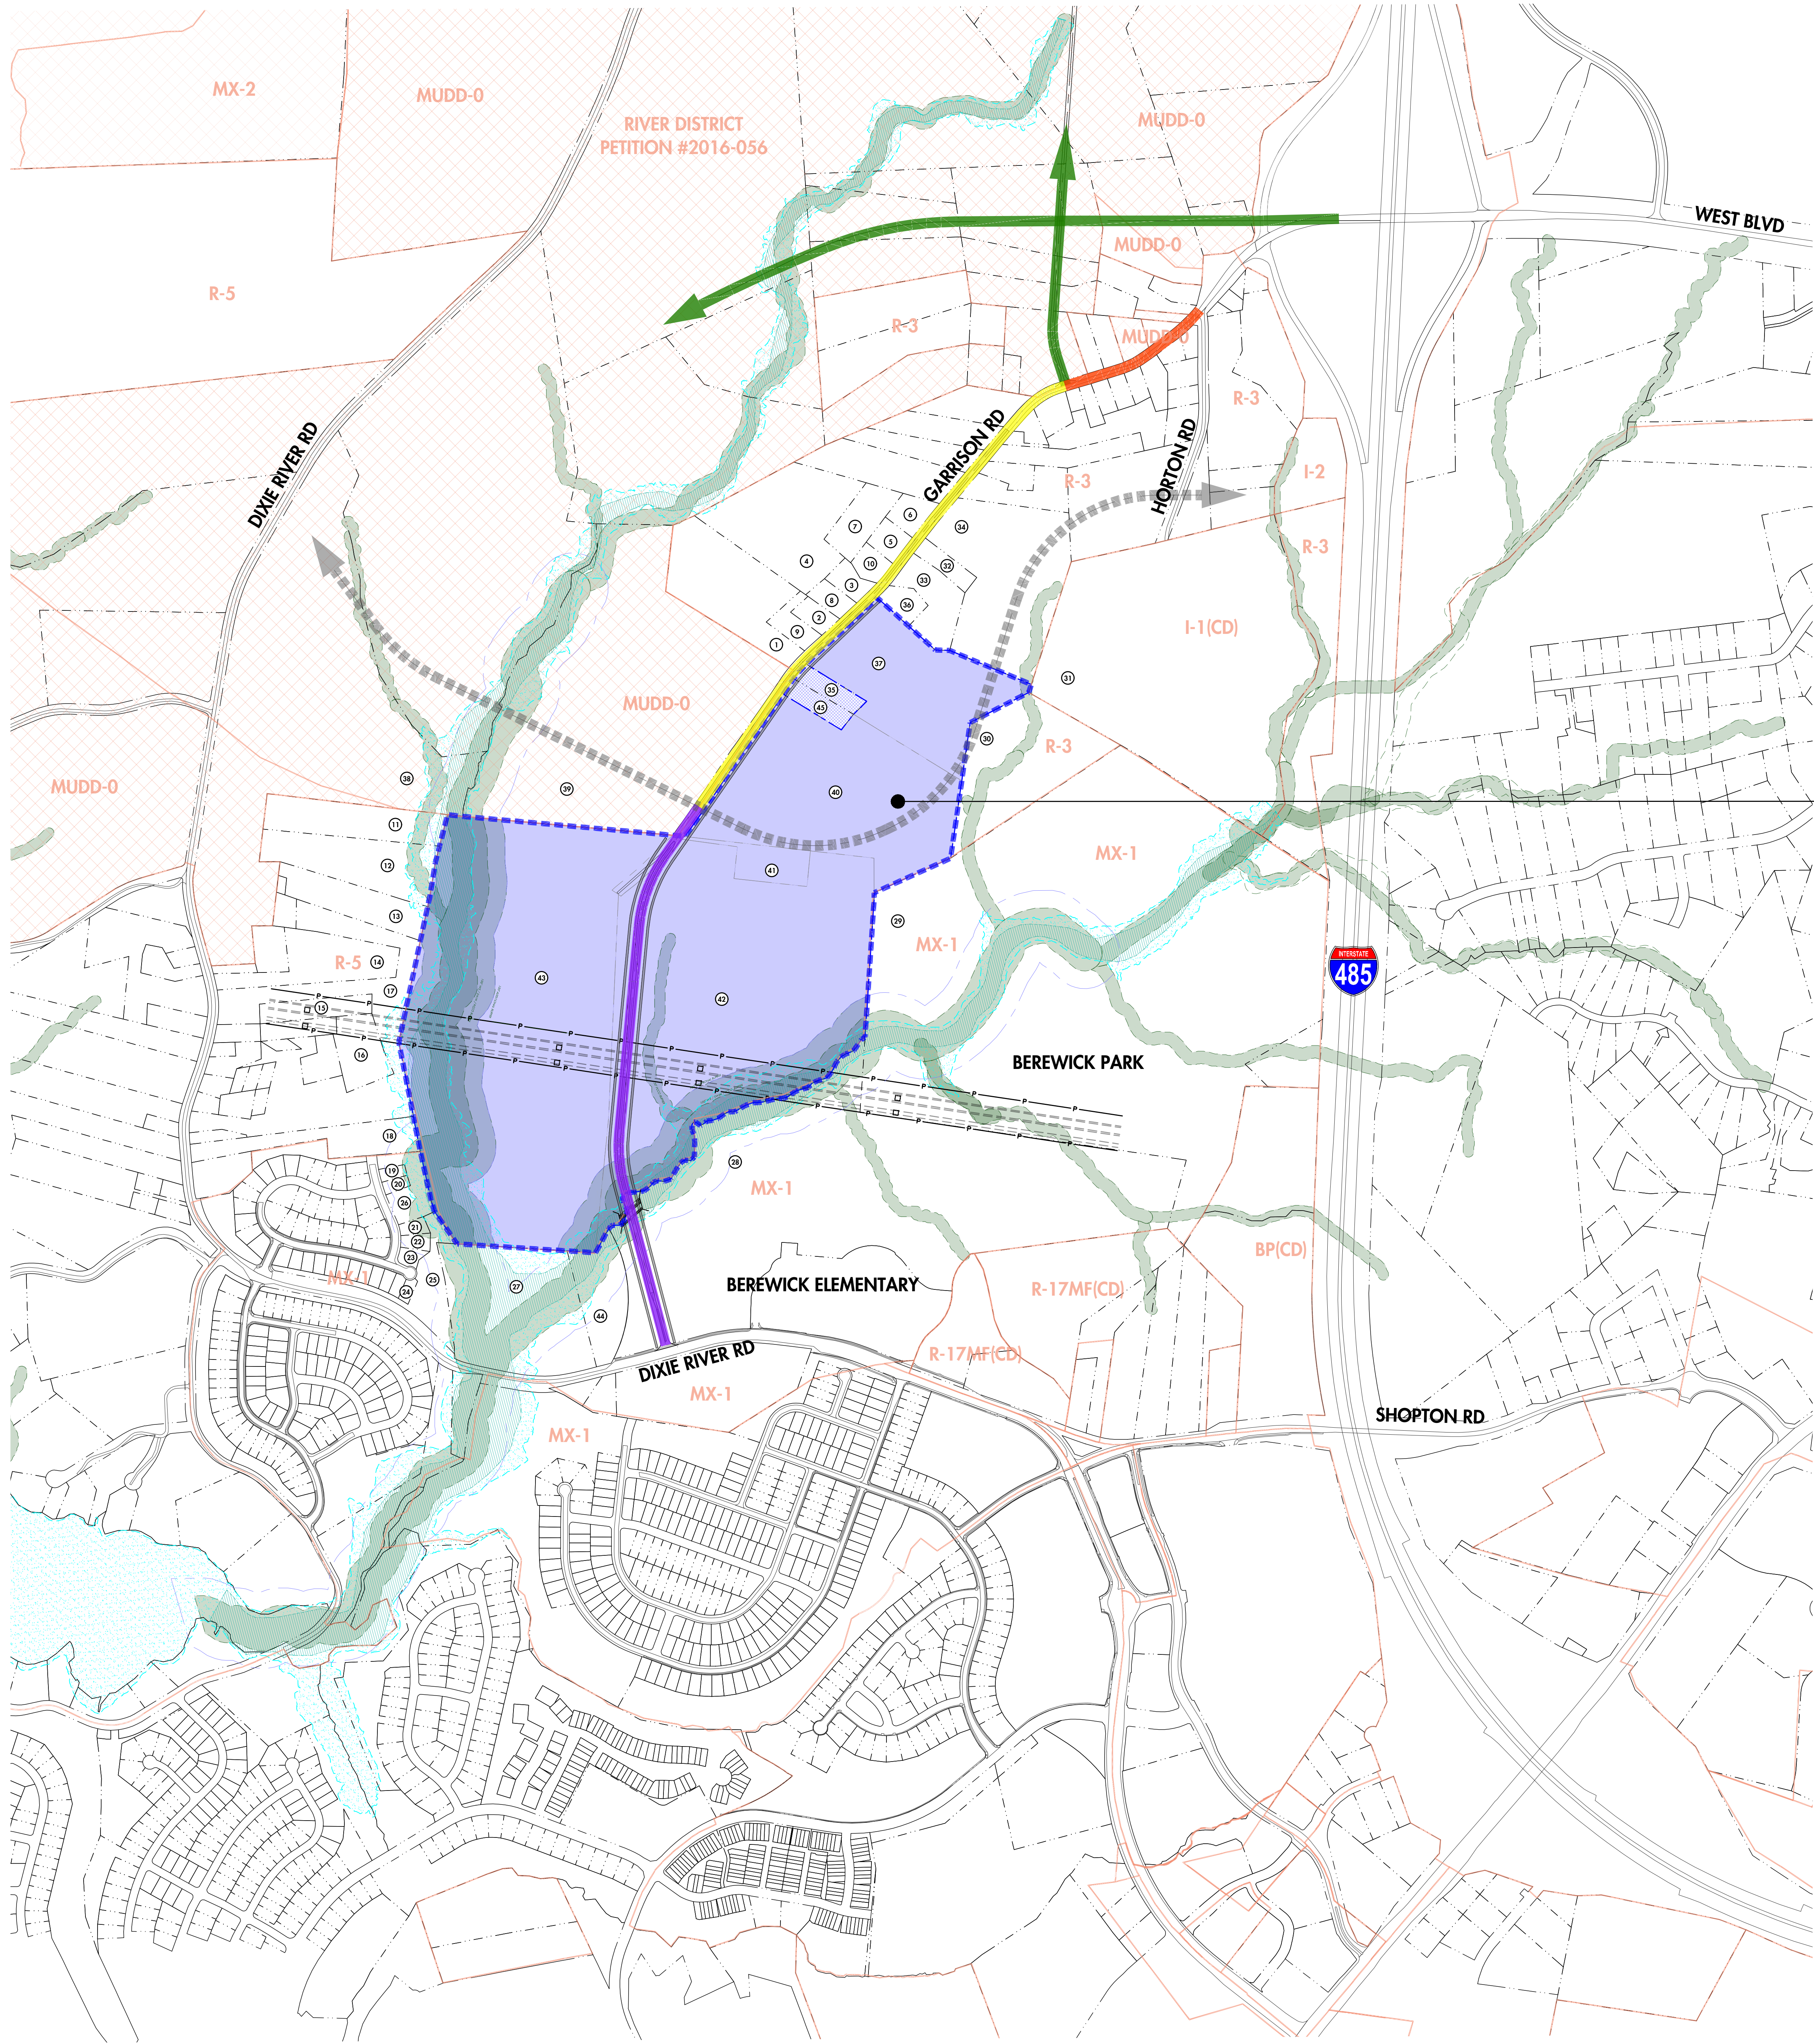

**PROPOSED REZONING**  
EXISTING ZONING: R-3  
PROPOSED ZONING: I-1(CD)


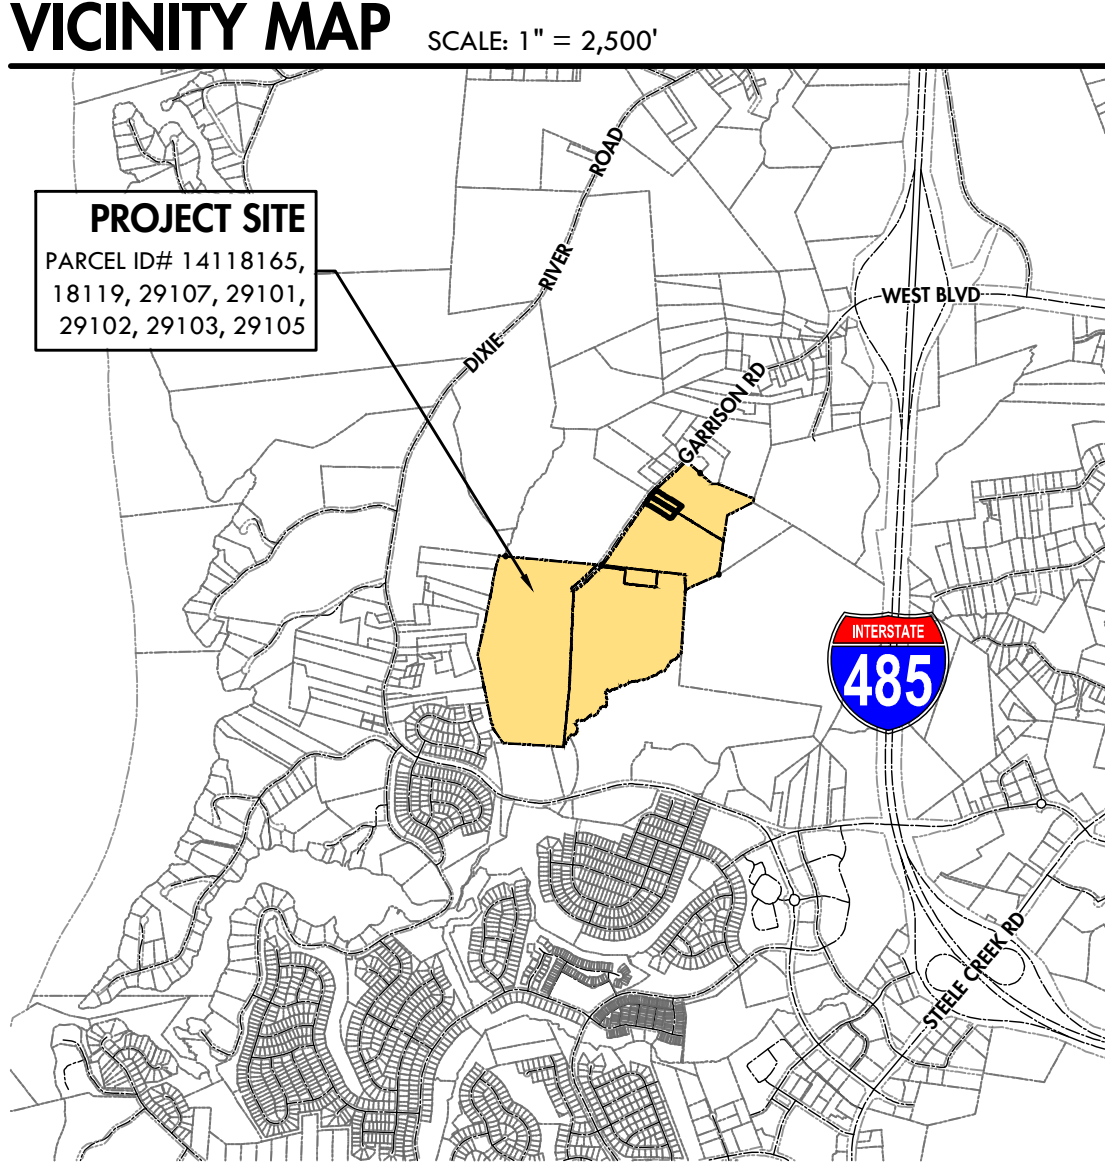


| SITE DEVELOPMENT TABLE   |                                                                                                                                                                                                                                        |
|--------------------------|----------------------------------------------------------------------------------------------------------------------------------------------------------------------------------------------------------------------------------------|
| PROJECT NAME:            | GARRISON ROAD INDUSTRIAL                                                                                                                                                                                                               |
| PETITION NO:             | # 2019-173                                                                                                                                                                                                                             |
| PETITIONER:              | MCCRANEY PROPERTY COMPANY                                                                                                                                                                                                              |
| PLANS PREPARED BY:       | OAK ENGINEERING, PLLC                                                                                                                                                                                                                  |
| ACREAGE:                 | ±150.0 ACRES                                                                                                                                                                                                                           |
| TAX PARCEL NUMBERS:      | 14118165, 14118119, 14129107, 14129101, 14129102, 14129103, 14129105                                                                                                                                                                   |
| CURRENT ZONING:          | R-3                                                                                                                                                                                                                                    |
| PROPOSED ZONING:         | I-1 (CD)                                                                                                                                                                                                                               |
| OVERLAY DISTRICT:        | LOWER LAKE WYLIE PROTECTED AREA OVERLAY                                                                                                                                                                                                |
| EXISTING USE:            | VACANT / RESIDENTIAL                                                                                                                                                                                                                   |
| PROPOSED LAND USE:       | OFFICE / WAREHOUSING / INDUSTRIAL<br>(ALL USES ALLOWED BY RIGHT AND UNDER PRESCRIBED CONDITIONS TOGETHER WITH ACCESSORY USES, ALL AS ALLOWED IN THE I-1 ZONING DISTRICT (AS MORE SPECIFICALLY DESCRIBED IN THE DEVELOPMENT STANDARDS.) |
| MAXIMUM GFA:             | 1,450,000 SF                                                                                                                                                                                                                           |
| MAXIMUM HEIGHT:          | HEIGHT AS PERMITTED BY ORDINANCE AND WILL BE MEASURED AS DEFINED BY THE ORDINANCE.                                                                                                                                                     |
| PARKING:                 | AS REQUIRED BY THE ORDINANCE FOR THE PERMITTED USES                                                                                                                                                                                    |
| JURISDICTION:            | CITY OF CHARLOTTE                                                                                                                                                                                                                      |
| PCSO WATERSHED DISTRICT: | WESTERN CATAWBA                                                                                                                                                                                                                        |
| FEMA INFORMATION:        | MAP NO. 3710450200L<br>MAP DATES: 9/2/2015<br>FLOOD ZONE: AE / X                                                                                                                                                                       |

| ROAD IMPROVEMENTS |                                                                                                                            |
|-------------------|----------------------------------------------------------------------------------------------------------------------------|
|                   | WEST BOULEVARD IMPROVEMENTS<br>(PUBLIC PRIVATE PARTNERSHIP - BY OTHERS)                                                    |
|                   | GARRISON ROAD IMPROVEMENTS                                                                                                 |
|                   | PHASE ONE                                                                                                                  |
|                   | PHASE TWO                                                                                                                  |
|                   | ALTERNATE GARRISON ROAD IMPROVEMENTS<br>(EXTEND IMPROVEMENTS TO HORTON ROAD DEPENDING ON TIMING OF WEST BOULEVARD PROJECT) |
|                   | FUTURE CATAWBA CROSSING<br>(RIGHT-OF-WAY RESERVATION)                                                                      |

| ADJACENT PROPERTY OWNERS |          |                                |                       |       |                         |
|--------------------------|----------|--------------------------------|-----------------------|-------|-------------------------|
| #                        | PID      | LAST NAME                      | FIRST NAME            | DB    | SITE ADDRESS            |
| 1                        | 14114101 | RUSHING                        | RONNIE DUCE           | 28678 | 312 GARRISON RD         |
| 2                        | 14114102 | RUSHING                        | JAMES WARREN          | 18308 | 10428 GARRISON RD       |
| 3                        | 14114103 | SWANEY                         | ROBERT L SR           | 6348  | 10406 GARRISON RD       |
| 4                        | 14114104 | RUSHING                        | RONNIE DUCE           | 28678 | 312 10408 GARRISON RD   |
| 5                        | 14114105 | SWANEY                         | EVA C                 | 29641 | 693 10308 GARRISON RD   |
| 6                        | 14114106 | RUSHING                        | GRADY S L/E           | 18376 | 745 10300 GARRISON RD   |
| 7                        | 14114110 | RUSHING                        | RONNIE DUCE           | 28678 | 312 GARRISON RD         |
| 8                        | 14114113 | SWANEY                         | ROBERT L SR           | 4846  | 302 10412 GARRISON RD   |
| 9                        | 14114114 | RUSHING                        | RONNIE D              | 5208  | 798 10502 GARRISON RD   |
| 10                       | 14114115 | RUSHING                        | RONNIE DUCE JR        | 27979 | 329 10338 GARRISON RD   |
| 11                       | 14116102 | CROSBY                         | LACHELLE M            | 31340 | 5 7242 DIXIE RIVER RD   |
| 12                       | 14116103 | SHORT                          | KYLE                  | 31692 | 83 7052 DIXIE RIVER RD  |
| 13                       | 14116104 | WOODARD                        | HENRIETTA             | 1604  | 593 7048 DIXIE RIVER RD |
| 14                       | 14116111 | BROWN                          | CARRIETTA A           | 31458 | 779 7006 DIXIE RIVER RD |
| 15                       | 14116114 | HALL                           | LEE                   | 1632  | 469 DIXIE RIVER RD      |
| 16                       | 14116115 | POTTS                          | KERMIT                | 33946 | 161 DIXIE RIVER RD      |
| 17                       | 14116120 | GRIER                          | BERNIE WALLACE        | 1154  | 397 6820 DIXIE RIVER RD |
| 18                       | 14116123 | ONSITE HOLDINGS LLC            |                       | 27099 | 305 6810 DIXIE RIVER RD |
| 19                       | 14116175 | BYRUM JR                       | ROBERT F              | 32516 | 586 7504 CANOVA LN      |
| 20                       | 14116176 | PETERSON                       | TAD                   | 32226 | 384 7428 CANOVA LN      |
| 21                       | 14116177 | SUMNER                         | ERIN NICOLE STARNES   | 31894 | 350 7412 CANOVA LN      |
| 22                       | 14116178 | PATIL                          | SADANAND SANJEEVKUMAR | 32659 | 370 7408 CANOVA LN      |
| 23                       | 14116179 | BARTLETT                       | NICOLE L              | 30828 | 922 7404 CANOVA LN      |
| 24                       | 14116180 | FINAN                          | JEFFREY D             | 30589 | 465 9238 LOCH GLEN WY   |
| 25                       | 14116193 | BEREWICK HOMEOWNERS ASSOC. INC |                       | 33446 | 264 LOCH GLEN WY        |
| 26                       | 14116196 | BEREWICK HOMEOWNERS ASSOC. INC |                       | 33446 | 264 CANOVA LN           |
| 27                       | 14117101 | DIXIE RIVER LAND COMPANY LLC   |                       | 12722 | 642 6332 DIXIE RIVER RD |
| 28                       | 14117111 | MECKLENBURG COUNTY             |                       | 14350 | 402 5910 DIXIE RIVER RD |
| 29                       | 14117112 | MECKLENBURG COUNTY             |                       | 14350 | 408 DIXIE RIVER RD      |
| 30                       | 14118101 | MECKLENBURG COUNTY             |                       | 23229 | 795 GARRISON RD         |
| 31                       | 14118102 | SL HORTON ROAD LLC             |                       | 32765 | 3 10137 HORTON RD       |
| 32                       | 14118116 | SWANEY                         | ROBERT L              | 3328  | 259 10301 GARRISON RD   |
| 33                       | 14118117 | SWANEY                         | ROBERT L              | 3620  | 925 10309 GARRISON RD   |
| 34                       | 14118118 | HIGGINS                        | SHERI S               | 27004 | 414 GARRISON RD         |
| 35                       | 14118119 | MOBLEY                         | CHARLES DOUGLAS       | 27556 | 198 10515 GARRISON RD   |
| 36                       | 14118128 | SWANEY                         | ROBERT L              | 5744  | 479 10315 GARRISON RD   |
| 37                       | 14118165 | TSC GARRISON LLC               |                       | 32652 | 372 GARRISON RD         |
| 38                       | 14128101 | CRESCENT COMMUNITIES II LLC    |                       | 32809 | 788 DIXIE RIVER RD      |
| 39                       | 14128102 | CRESCENT COMMUNITIES II LLC    |                       | 32809 | 788 DIXIE RIVER RD      |
| 40                       | 14129101 | SHAW                           | WILLIAM A JR          | 25338 | 394 GARRISON RD         |
| 41                       | 14129102 | BURRIS                         | DWIGHT D              | 5446  | 563 10731 GARRISON RD   |
| 42                       | 14129103 | SHAW                           | WILLIAM A JR          | N/A   | N/A 10813 GARRISON RD   |
| 43                       | 14129105 | BURRIS HOLDINGS LLC            |                       | 12002 | 826 GARRISON RD         |
| 44                       | 14129106 | MECKLENBURG COUNTY             |                       | 24799 | 269 GARRISON RD         |
| 45                       | 14129107 | MOBLEY                         | CHARLES DOUGLAS       | 27556 | 198 GARRISON RD         |

SHADED PARCELS INCLUDED IN REZONING PETITION

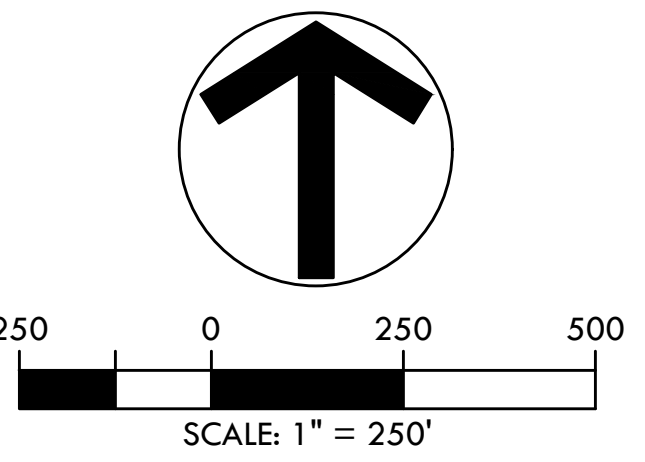
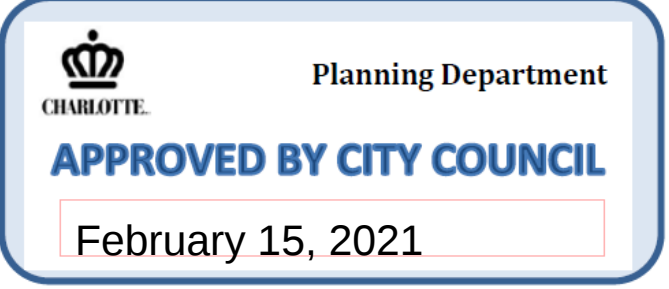


ENGINEER: GTW  
DRAWN BY: ERT  
CHECKED BY: LJB  
PROJECT #: 019.039  
SHEET  
RZ-1  
SHEET 1 OF 5

**GARRISON ROAD INDUSTRIAL**  
REZONING PETITION NUMBER 2019-173  
CHARLOTTE, NORTH CAROLINA  
MCCRANEY PROPERTY COMPANY  
TECHNICAL DATA SHEET

**OAK**  
ENGINEERING  
4929 MONROE ROAD, CHARLOTTE, NC 28205  
NORTH CAROLINA LICENSE #17142  
oak-engineering.com

PE SEAL:  
NORTH CAROLINA PROFESSIONAL ENGINEER  
SEAL 33996  
EXPIRATION DATE 12/31/2024

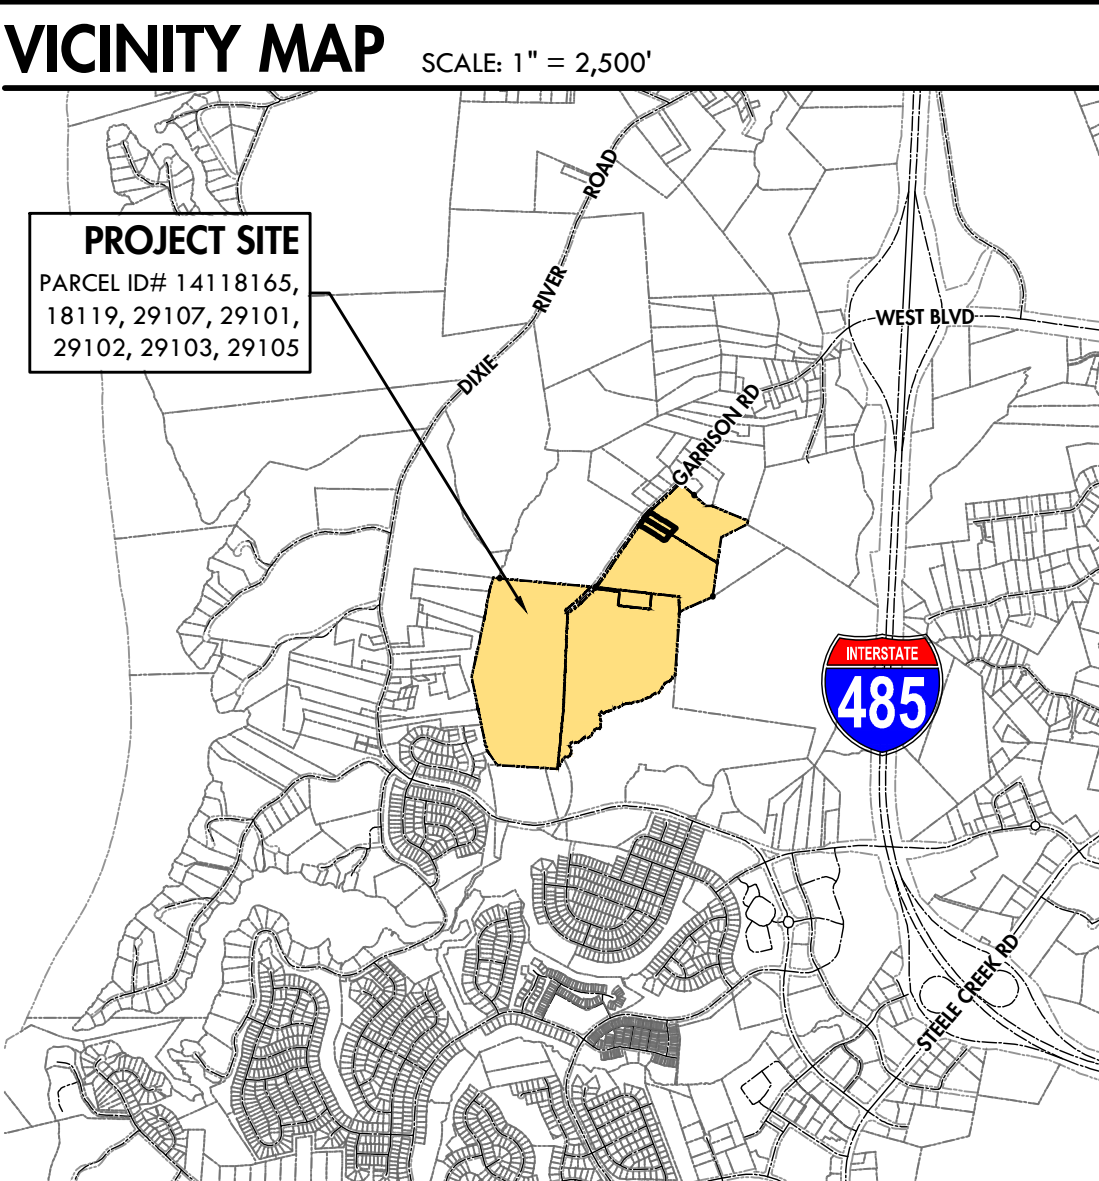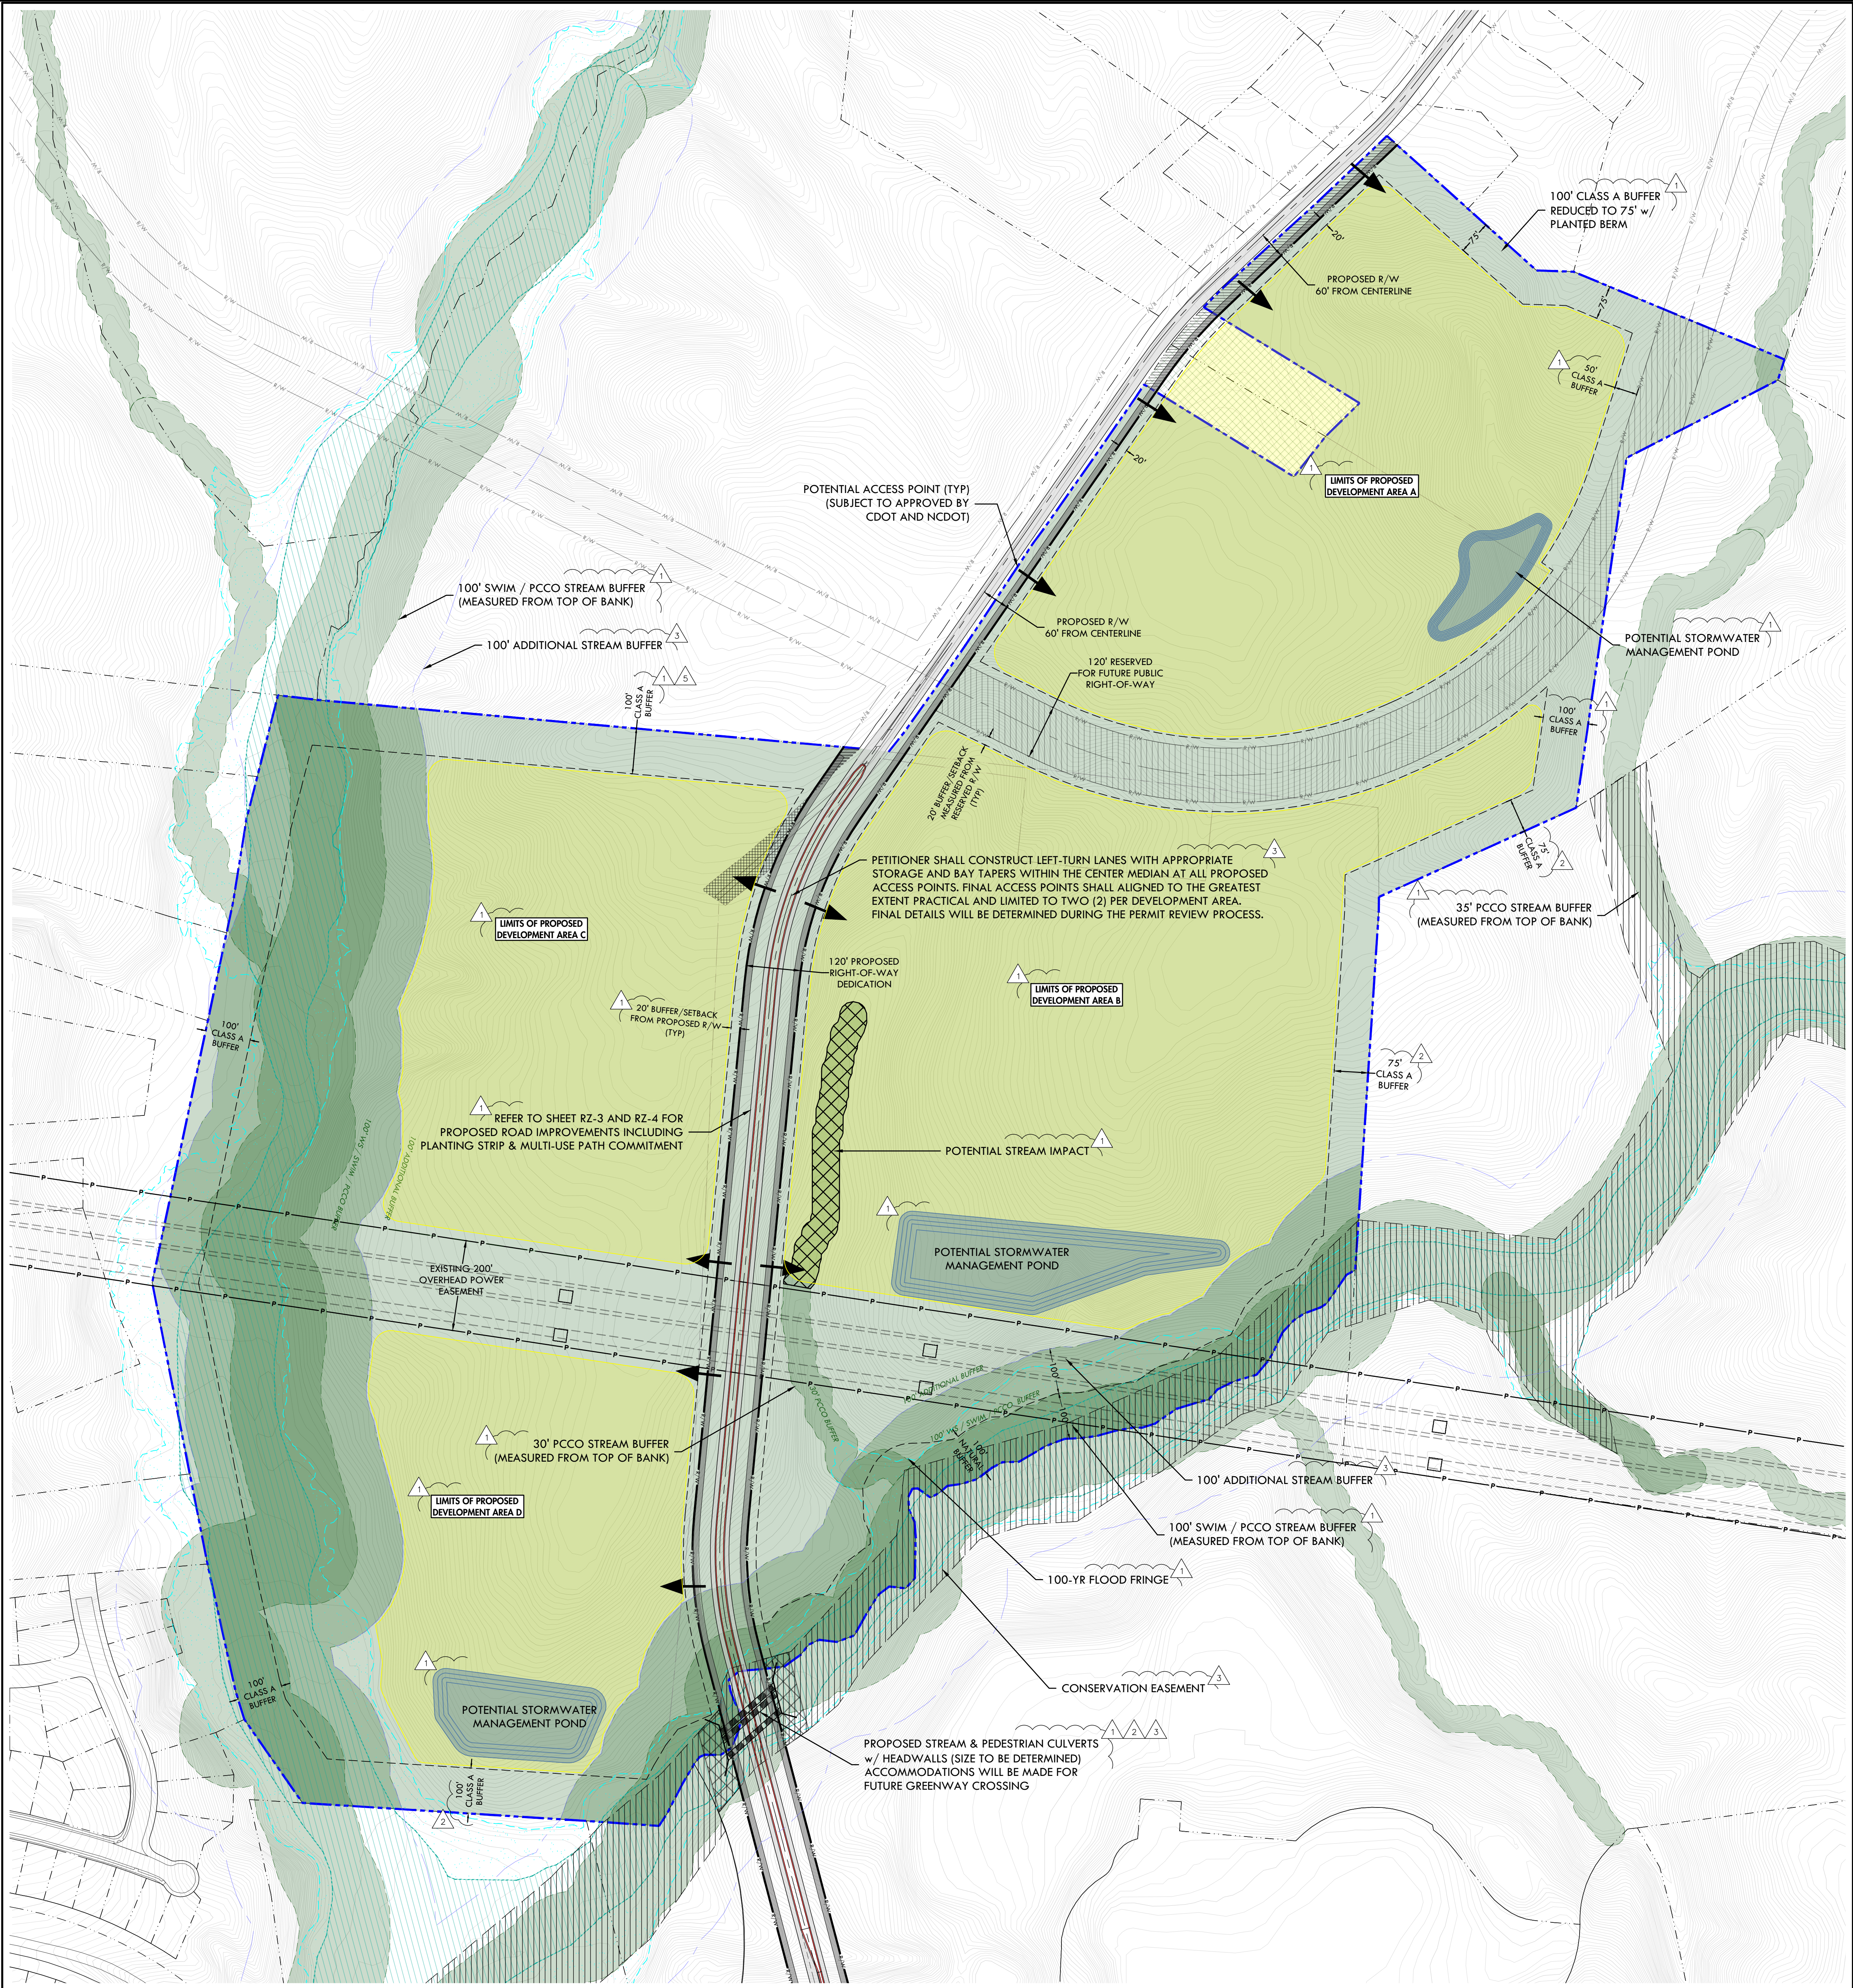


| SITE DEVELOPMENT TABLE   |                                                                                                                                                                                                                                        |
|--------------------------|----------------------------------------------------------------------------------------------------------------------------------------------------------------------------------------------------------------------------------------|
| PROJECT NAME:            | GARRISON ROAD INDUSTRIAL                                                                                                                                                                                                               |
| PETITION NO:             | # 2019-173                                                                                                                                                                                                                             |
| PETITIONER:              | MCCRANEY PROPERTY COMPANY                                                                                                                                                                                                              |
| PLANS PREPARED BY:       | OAK ENGINEERING, PLLC                                                                                                                                                                                                                  |
| ACREAGE:                 | ±150.0 ACRES                                                                                                                                                                                                                           |
| TAX PARCEL NUMBERS:      | 14118165, 14118119, 14129107, 14129101, 14129102, 14129103, 14129105                                                                                                                                                                   |
| CURRENT ZONING:          | R-3                                                                                                                                                                                                                                    |
| PROPOSED ZONING:         | I-1 (CD)                                                                                                                                                                                                                               |
| OVERLAY DISTRICT:        | LOWER LAKE WYLIE PROTECTED AREA OVERLAY                                                                                                                                                                                                |
| EXISTING USE:            | VACANT / RESIDENTIAL                                                                                                                                                                                                                   |
| PROPOSED LAND USE:       | OFFICE / WAREHOUSING / INDUSTRIAL<br>(ALL USES ALLOWED BY RIGHT AND UNDER PRESCRIBED CONDITIONS TOGETHER WITH ACCESSORY USES, ALL AS ALLOWED IN THE I-1 ZONING DISTRICT (AS MORE SPECIFICALLY DESCRIBED IN THE DEVELOPMENT STANDARDS.) |
| MAXIMUM GFA:             | 1,450,000 SF                                                                                                                                                                                                                           |
| MAXIMUM HEIGHT:          | HEIGHT AS PERMITTED BY ORDINANCE AND WILL BE MEASURED AS DEFINED BY THE ORDINANCE.                                                                                                                                                     |
| PARKING:                 | AS REQUIRED BY THE ORDINANCE FOR THE PERMITTED USES                                                                                                                                                                                    |
| JURISDICTION:            | CITY OF CHARLOTTE                                                                                                                                                                                                                      |
| PCSO WATERSHED DISTRICT: | WESTERN CATAWBA                                                                                                                                                                                                                        |
| FEMA INFORMATION:        | MAP NO. 3710450200L<br>MAP DATES: 9/2/2015<br>FLOOD ZONE: AE / X                                                                                                                                                                       |

**DRIVEWAY NOTE:**

THE FOLLOWING ARE REQUIREMENTS OF THE DEVELOPER THAT MUST BE SATISFIED PRIOR TO DRIVEWAY PERMIT APPROVAL.

1. ACCORDING TO THE CITY OF CHARLOTTE'S DRIVEWAY REGULATIONS, CDOT HAS THE AUTHORITY TO REGULATE/APPROVE ALL PRIVATE STREET/DRIVEWAY AND PUBLIC STREET CONNECTIONS TO THE RIGHT-OF-WAY OF A STREET UNDER THE REGULATORY JURISDICTION OF THE CITY OF CHARLOTTE.
2. ADEQUATE RIGHT TRIANGLES MUST BE RESERVED AT THE EXISTING/PROPOSED STREET ENTRANCE(S). TWO 35' X 35' RIGHT TRIANGLES (AND TWO 10' X 70' RIGHT TRIANGLES ON NORTH CAROLINA DEPARTMENT OF TRANSPORTATION ON NCDOT MAINTAINED STREETS) ARE REQUIRED FOR THE ENTRANCE(S) TO MEET REQUIREMENTS. ALL PROPOSED TREES, BERMS, WALLS, FENCES, AND/OR IDENTIFICATION SIGNS MUST NOT INTERFERE WITH SIGHT DISTANCE AT THE ENTRANCE(S). SUCH ITEMS SHOULD BE IDENTIFIED ON THE SITE PLAN.
3. THE PROPOSED DRIVEWAY CONNECTION(S) TO PUBLIC STREETS WILL REQUIRE A DRIVEWAY PERMIT(S) TO BE SUBMITTED TO CDOT (AND THE NORTH CAROLINA DEPARTMENT OF TRANSPORTATION ON NCDOT MAINTAINED STREETS) FOR REVIEW AND APPROVAL. THE EXACT DRIVEWAY LOCATION(S) AND TYPE/WIDTH OF THE DRIVEWAY(S) WILL BE DETERMINED BY CDOT DURING THE DRIVEWAY PERMIT PROCESS. THE LOCATION(S) OF THE DRIVEWAY(S) SHOWN ON THE SITE PLAN ARE SUBJECT TO CHANGE IN ORDER TO ALIGN WITH DRIVEWAY(S) ON THE OPPOSITE SIDE OF THE STREET AND COMPLY WITH CITY DRIVEWAY REGULATIONS AND THE CITY TREE ORDINANCE.
4. ALL PROPOSED COMMERCIAL DRIVEWAY CONNECTIONS TO A FUTURE PUBLIC STREET WILL REQUIRE A DRIVEWAY PERMIT TO BE SUBMITTED TO CDOT FOR REVIEW AND APPROVAL.
5. ANY FENCE OR WALL CONSTRUCTED ALONG OR ADJACENT TO ANY SIDEWALK OR STREET RIGHT-OF-WAY REQUIRES A CERTIFICATE ISSUED BY CDOT.
6. A RIGHT-OF-WAY ENCROACHMENT AGREEMENT IS REQUIRED FOR THE INSTALLATION OF ANY NON-STANDARD ITEM(S) (IRRIGATION SYSTEMS, DECORATIVE CONCRETE PAVEMENT, BRICK PAVERS, ETC.) WITHIN A PROPOSED EXISTING CITY MAINTAINED STREET RIGHT-OF-WAY BY A PRIVATE INDIVIDUAL, GROUP, BUSINESS, OR HOMEOWNERS/BUSINESS ASSOCIATION. AN ENCROACHMENT AGREEMENT MUST BE APPROVED BY CDOT PRIOR TO THE CONSTRUCTION/INSTALLATION OF THE NON-STANDARD ITEM(S). CONTACT CDOT FOR ADDITIONAL INFORMATION CONCERNING COST, SUBMITTAL, AND LIABILITY INSURANCE COVERAGE REQUIREMENTS.

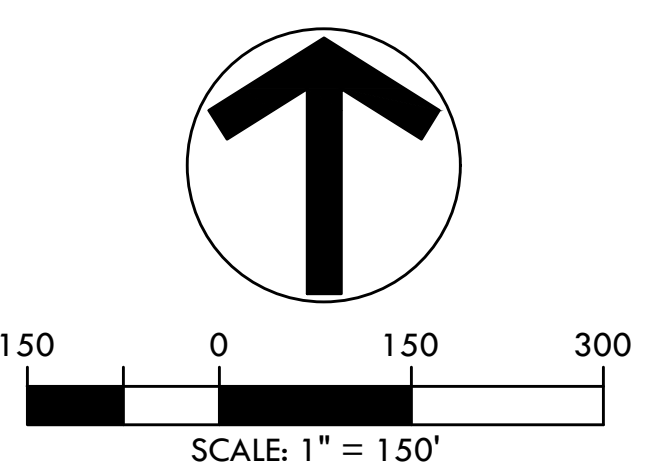

4929 MONROE ROAD, CHARLOTTE, NC 28205  
NORTH CAROLINA LICENSE #17142  
oak-engineering.com

PE SEAL:



**GARRISON ROAD INDUSTRIAL**  
REZONING PETITION NUMBER 2019-173  
CHARLOTTE, NORTH CAROLINA  
MCCRANEY PROPERTY COMPANY

**REZONING PLAN**

REVISIONS:

|    |                                     |
|----|-------------------------------------|
| 1. | 5/11/20 - CITY STAFF COMMENTS       |
| 2. | 8/24/20 - CITY STAFF COMMENTS       |
| 3. | 12/23/20 - CITY STAFF COMMENTS      |
| 4. | 1/27/21 - COORDINATION W/ CRESCENT  |
| 5. | 02/25/21 - COORDINATION W/ CRESCENT |



ENGINEER: GTW  
DRAWN BY: ERT  
CHECKED BY: LIB  
PROJECT #: 019.039  
SHEET  
**RZ-2**  
SHEET 2 OF 5

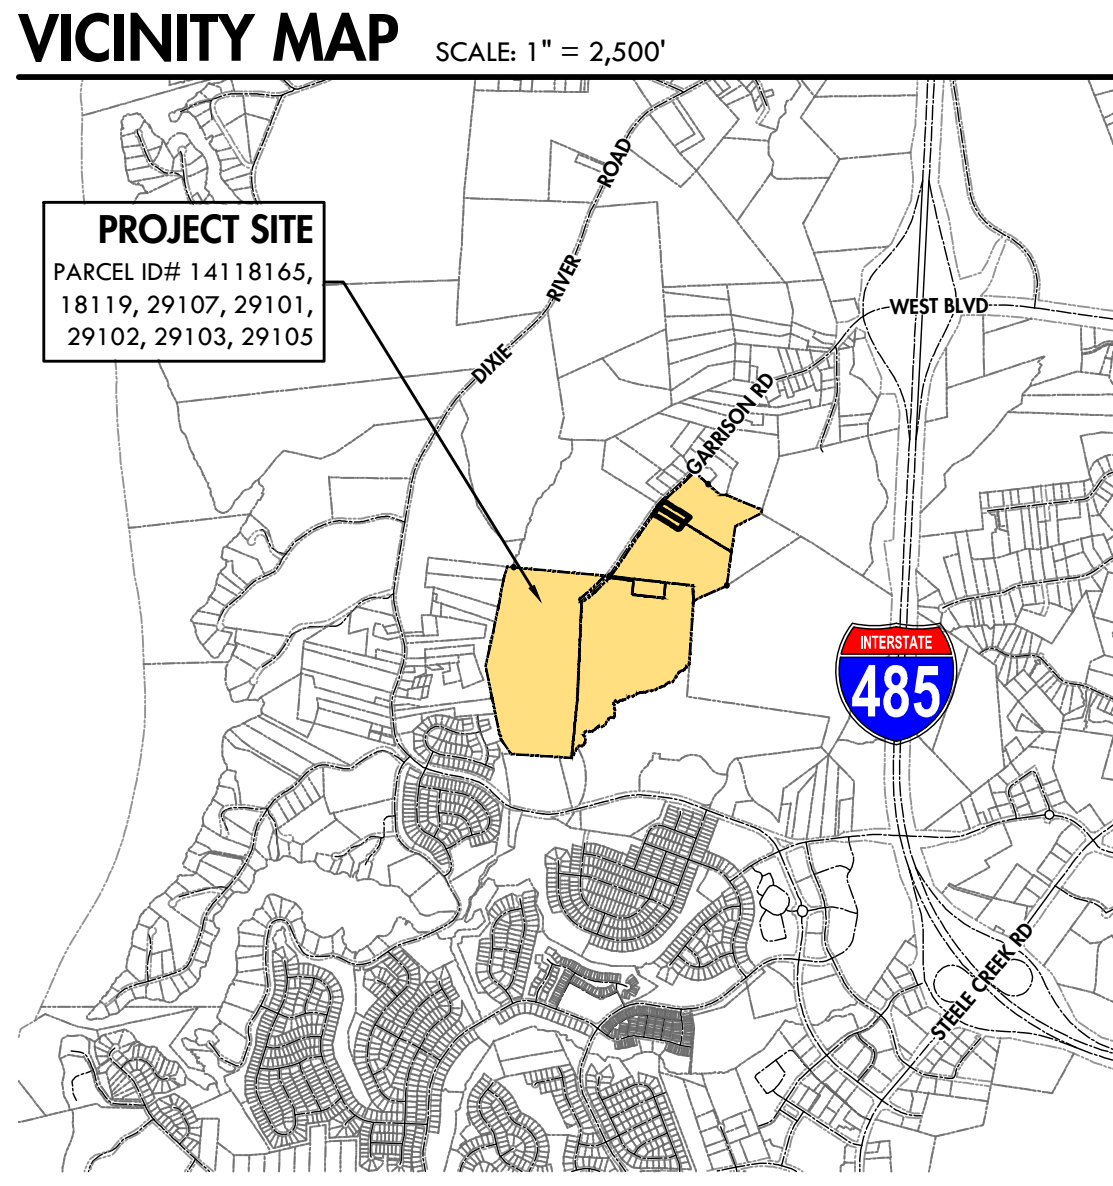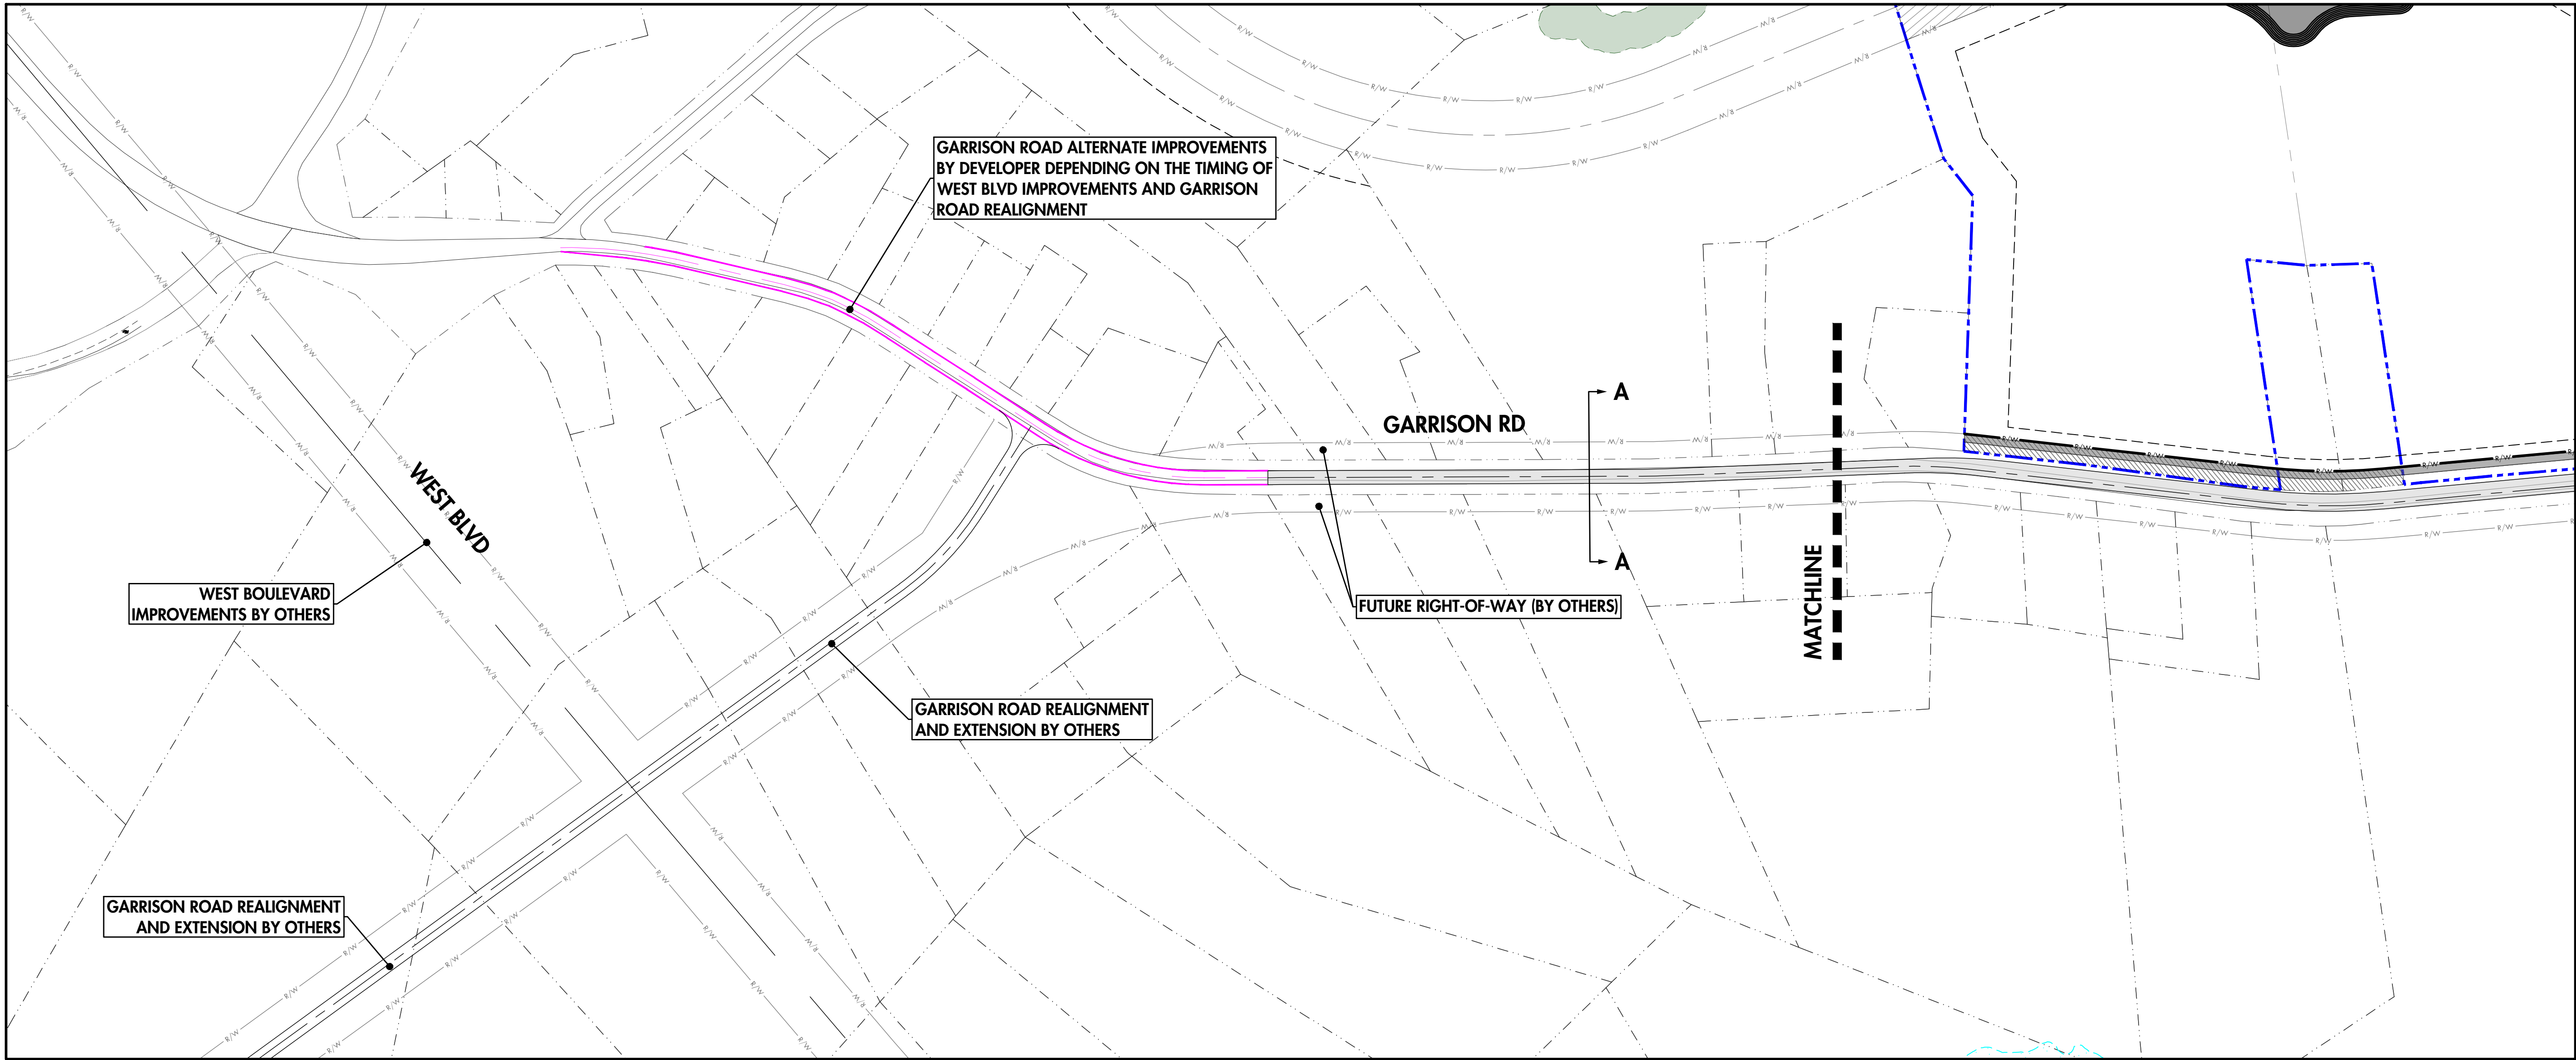

| SITE DEVELOPMENT TABLE   |                                                                                                                                                                                                                                         |
|--------------------------|-----------------------------------------------------------------------------------------------------------------------------------------------------------------------------------------------------------------------------------------|
| PROJECT NAME:            | GARRISON ROAD INDUSTRIAL                                                                                                                                                                                                                |
| PETITION NO:             | # 2019-173                                                                                                                                                                                                                              |
| PETITIONER:              | MCCRANEY PROPERTY COMPANY                                                                                                                                                                                                               |
| PLANS PREPARED BY:       | OAK ENGINEERING, PLLC                                                                                                                                                                                                                   |
| ACREAGE:                 | ±150.0 ACRES                                                                                                                                                                                                                            |
| TAX PARCEL NUMBERS:      | 14118165, 14118119, 14129107, 14129101, 14129102, 14129103, 14129105                                                                                                                                                                    |
| CURRENT ZONING:          | R-3                                                                                                                                                                                                                                     |
| PROPOSED ZONING:         | I-1 (CD)                                                                                                                                                                                                                                |
| OVERLAY DISTRICT:        | LOWER LAKE WYLIE PROTECTED AREA OVERLAY                                                                                                                                                                                                 |
| EXISTING USE:            | VACANT / RESIDENTIAL                                                                                                                                                                                                                    |
| PROPOSED LAND USE:       | OFFICE / WAREHOUSING / INDUSTRIAL<br>(ALL USES ALLOWED BY RIGHT AND UNDER PRESCRIBED CONDITIONS TOGETHER WITH ACCESSORY USES, ALL AS ALLOWED IN THE I-1 ZONING DISTRICT (AS MORE SPECIFICALLY DESCRIBED IN THE DEVELOPMENT STANDARDS).) |
| MAXIMUM GFA:             | 1,450,000 SF                                                                                                                                                                                                                            |
| MAXIMUM HEIGHT:          | HEIGHT AS PERMITTED BY ORDINANCE AND WILL BE MEASURED AS DEFINED BY THE ORDINANCE.                                                                                                                                                      |
| PARKING:                 | AS REQUIRED BY THE ORDINANCE FOR THE PERMITTED USES                                                                                                                                                                                     |
| JURISDICTION:            | CITY OF CHARLOTTE                                                                                                                                                                                                                       |
| PCSO WATERSHED DISTRICT: | WESTERN CATAWBA                                                                                                                                                                                                                         |
| FEMA INFORMATION:        | MAP NO. 3710450200L<br>MAP DATES: 9/2/2015<br>FLOOD ZONE: AE / X                                                                                                                                                                        |



FIGURE 1 - PROPOSED GUARD RAIL FEATURE AT STREAM CROSSING

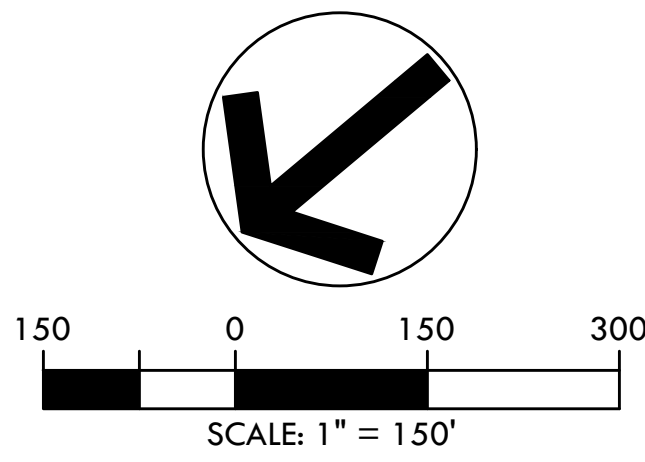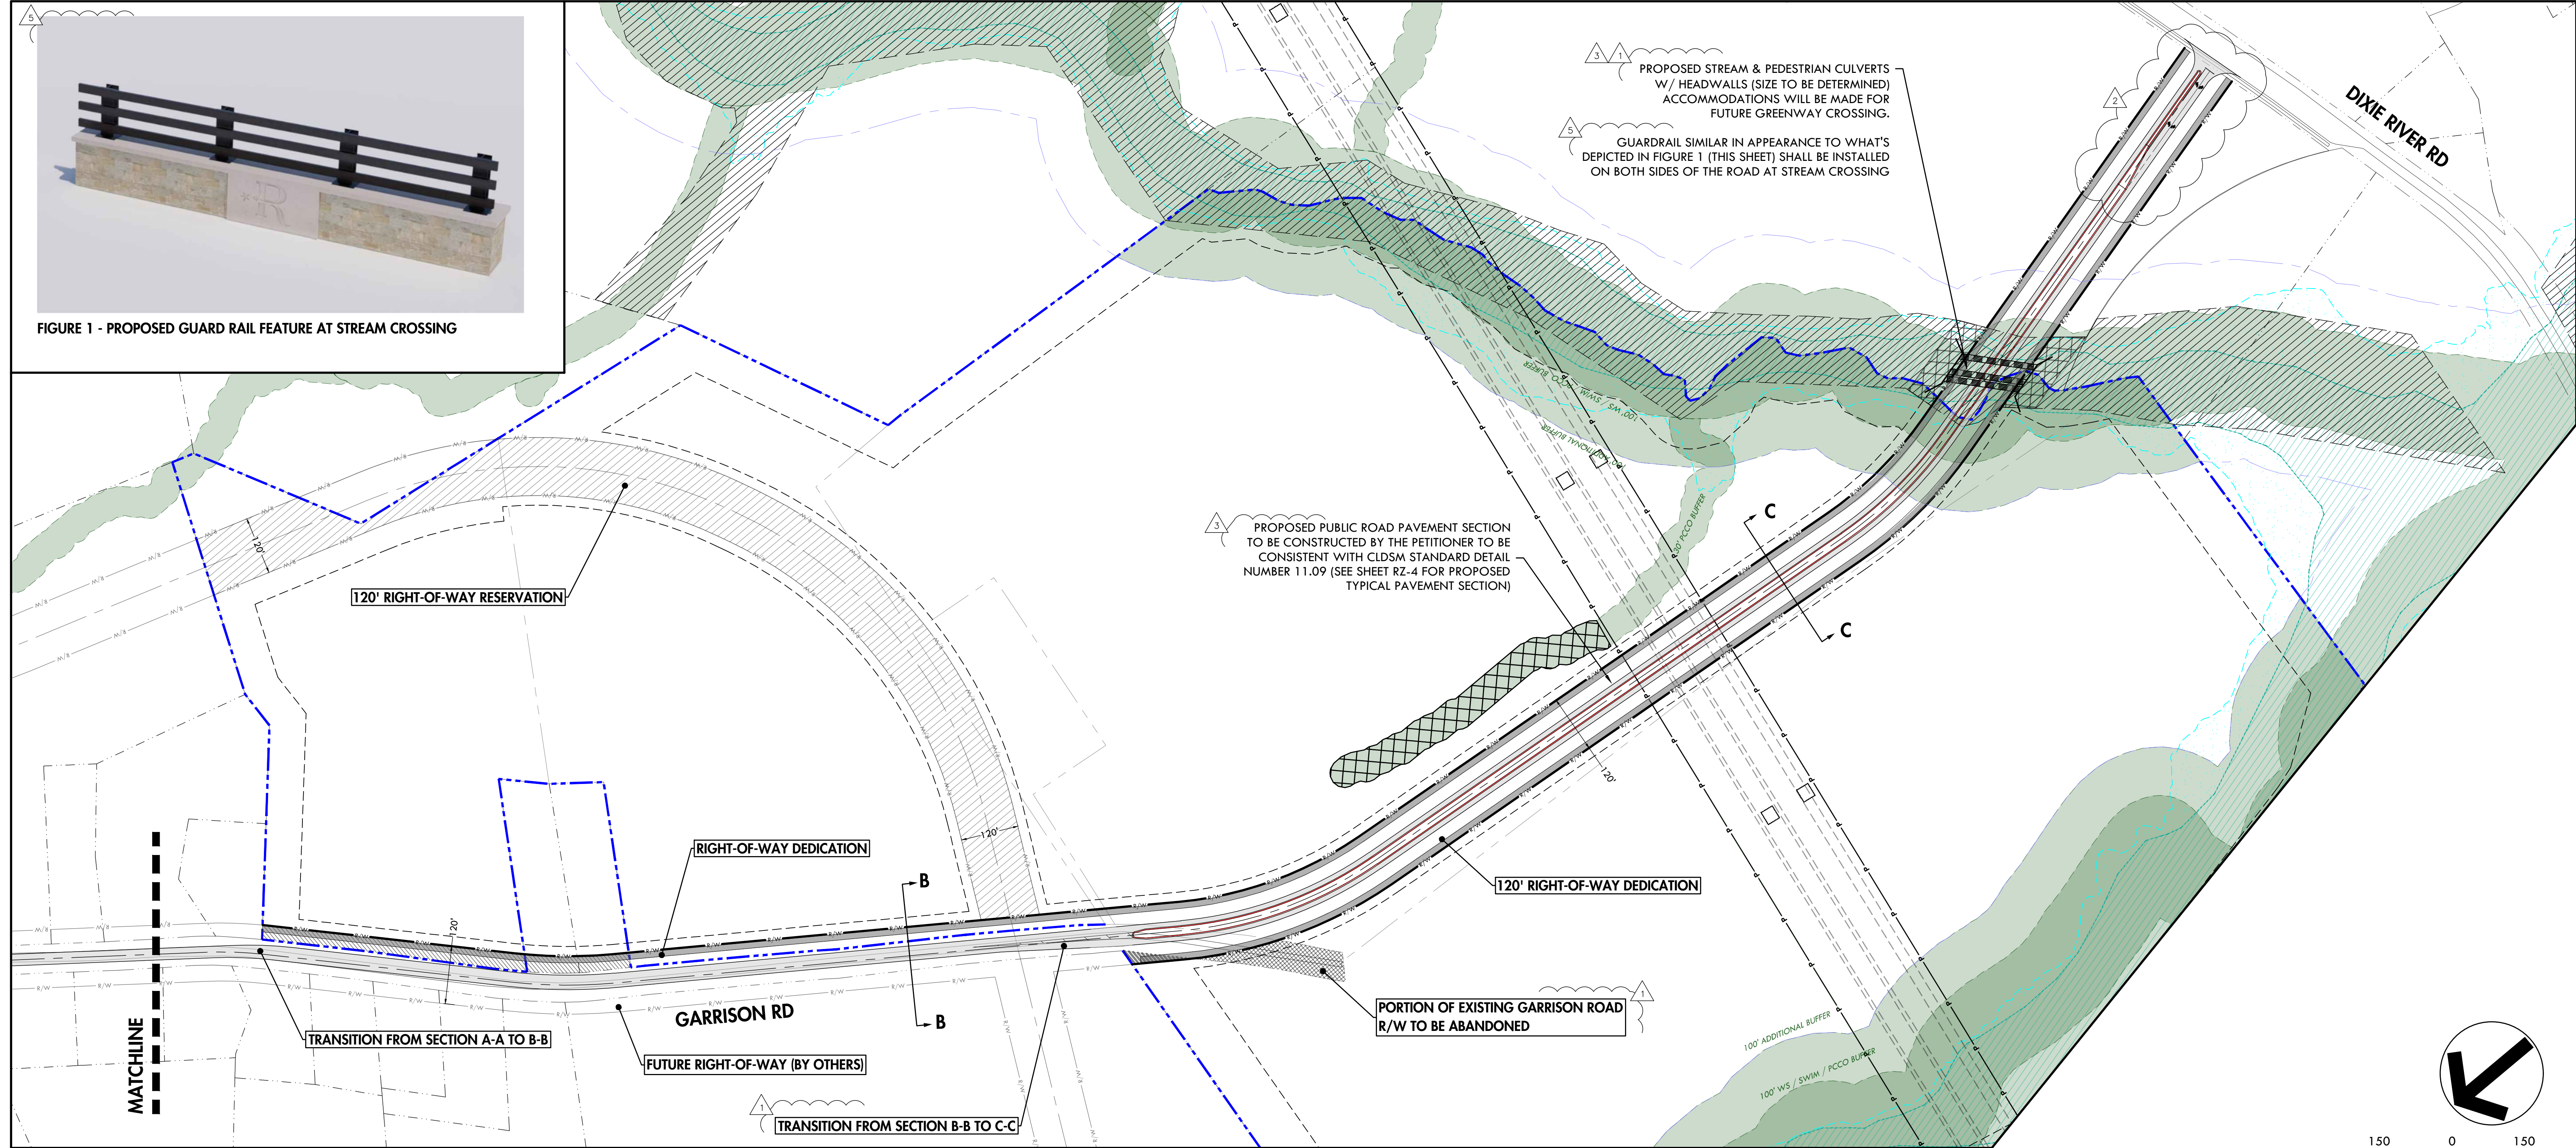

**GARRISON ROAD INDUSTRIAL**  
REZONING PETITION NUMBER 2019-173  
CHARLOTTE, NORTH CAROLINA  
MCCRANEY PROPERTY COMPANY

**TRANSPORTATION IMPROVEMENT PLAN**

ENGINEER: GTW  
DRAWN BY: ERT  
CHECKED BY: LJB  
PROJECT #: 019.039  
SHEET  
RZ-3  
SHEET 3 OF 5


- REVISIONS:
- 5/11/20 - CITY STAFF COMMENTS
  - 8/24/20 - CITY STAFF COMMENTS
  - 12/23/20 - CITY STAFF COMMENTS
  - 1/14/21 - CITY STAFF COMMENTS
  - 02/25/21 - COORDINATION W/ CRESCENT

**OAK**  
ENGINEERING


4929 MONROE ROAD, CHARLOTTE, NC 28205  
NORTH CAROLINA LICENSE #17142  
oak-engineering.com

PE SEAL:


NORTH CAROLINA  
PROFESSIONAL  
ENGINEER  
SEAL  
33996  
CRESCENT

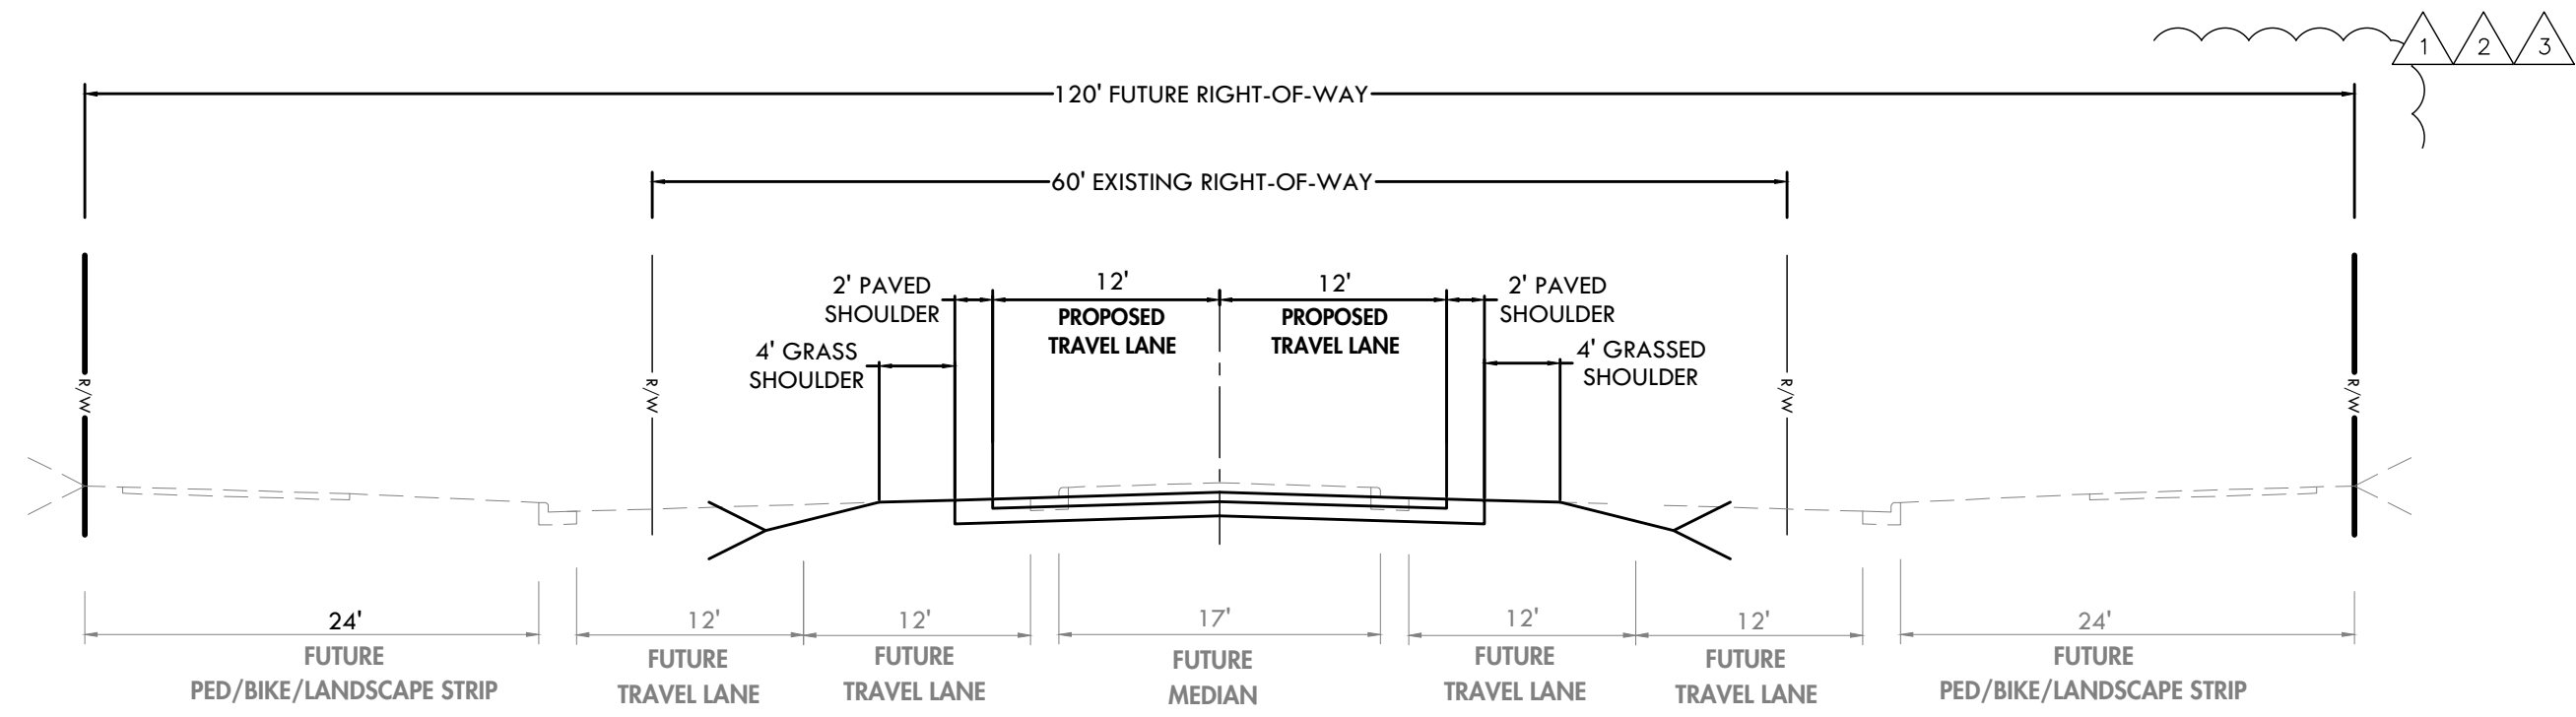

SECTION A - A  
PROPOSED ROAD IMPROVEMENTS  
(FUTURE BY OTHERS)

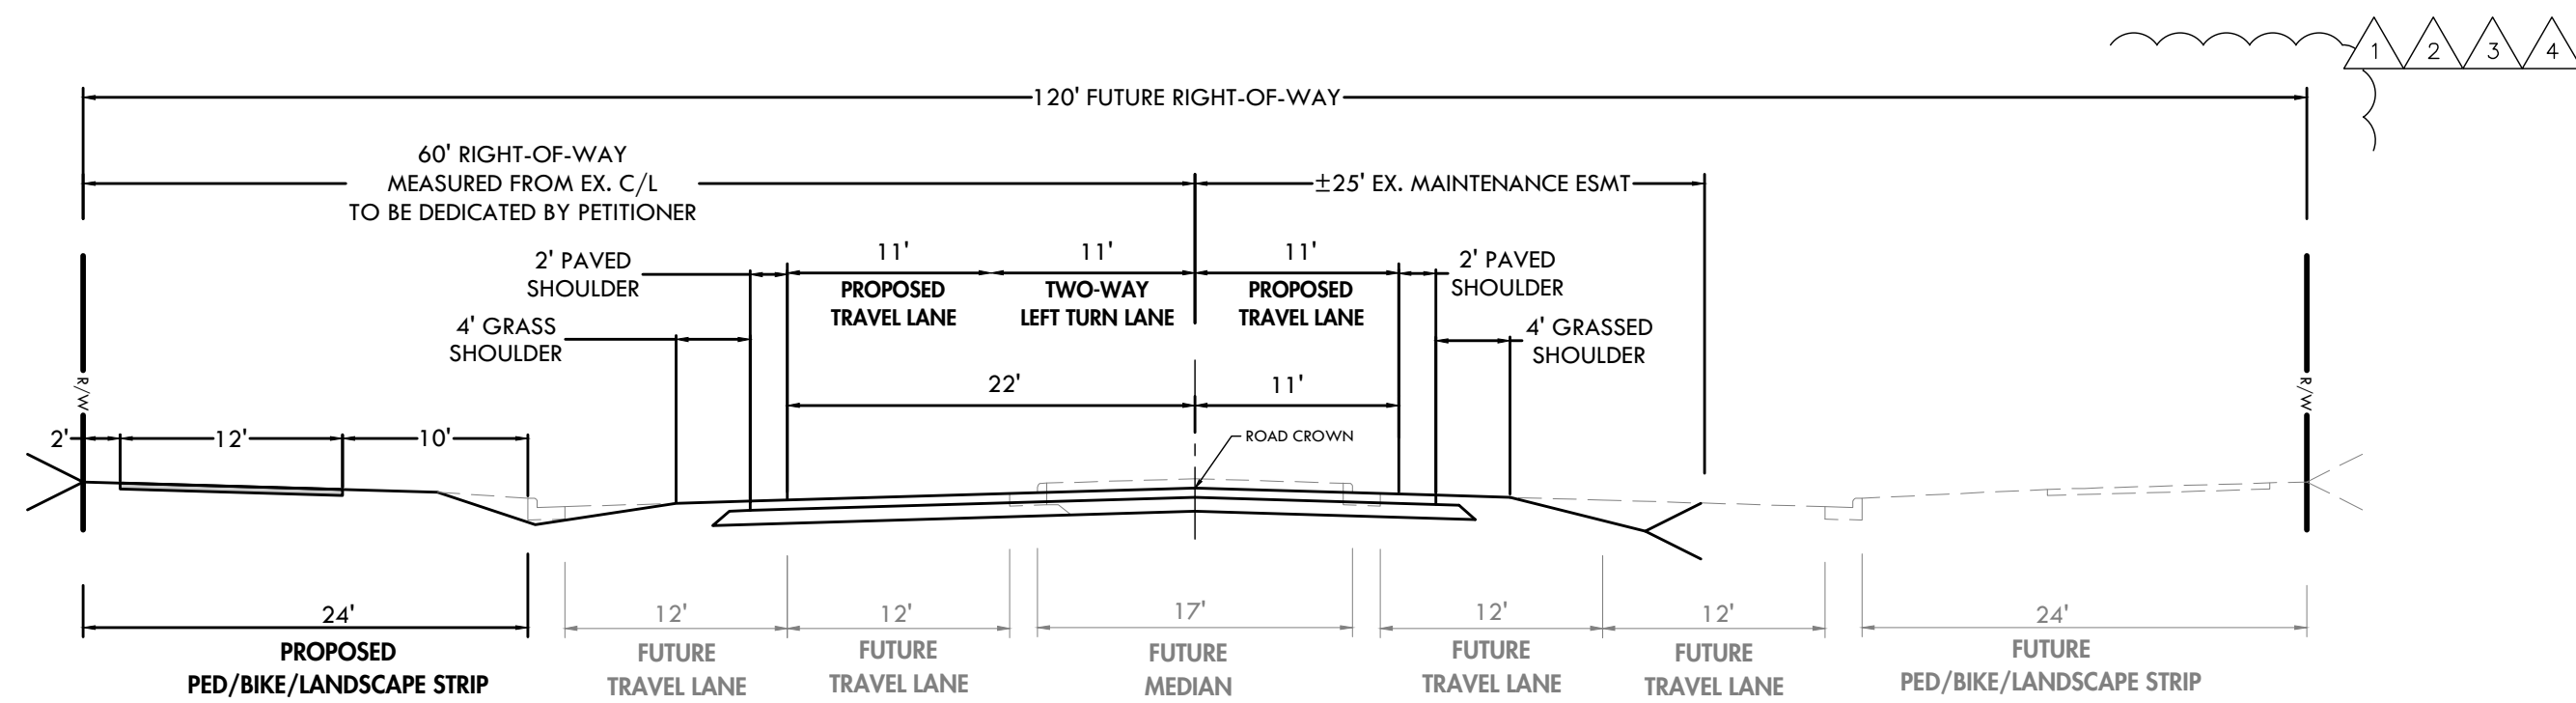

SECTION B - B  
PROPOSED ROAD IMPROVEMENTS  
(FUTURE BY OTHERS)

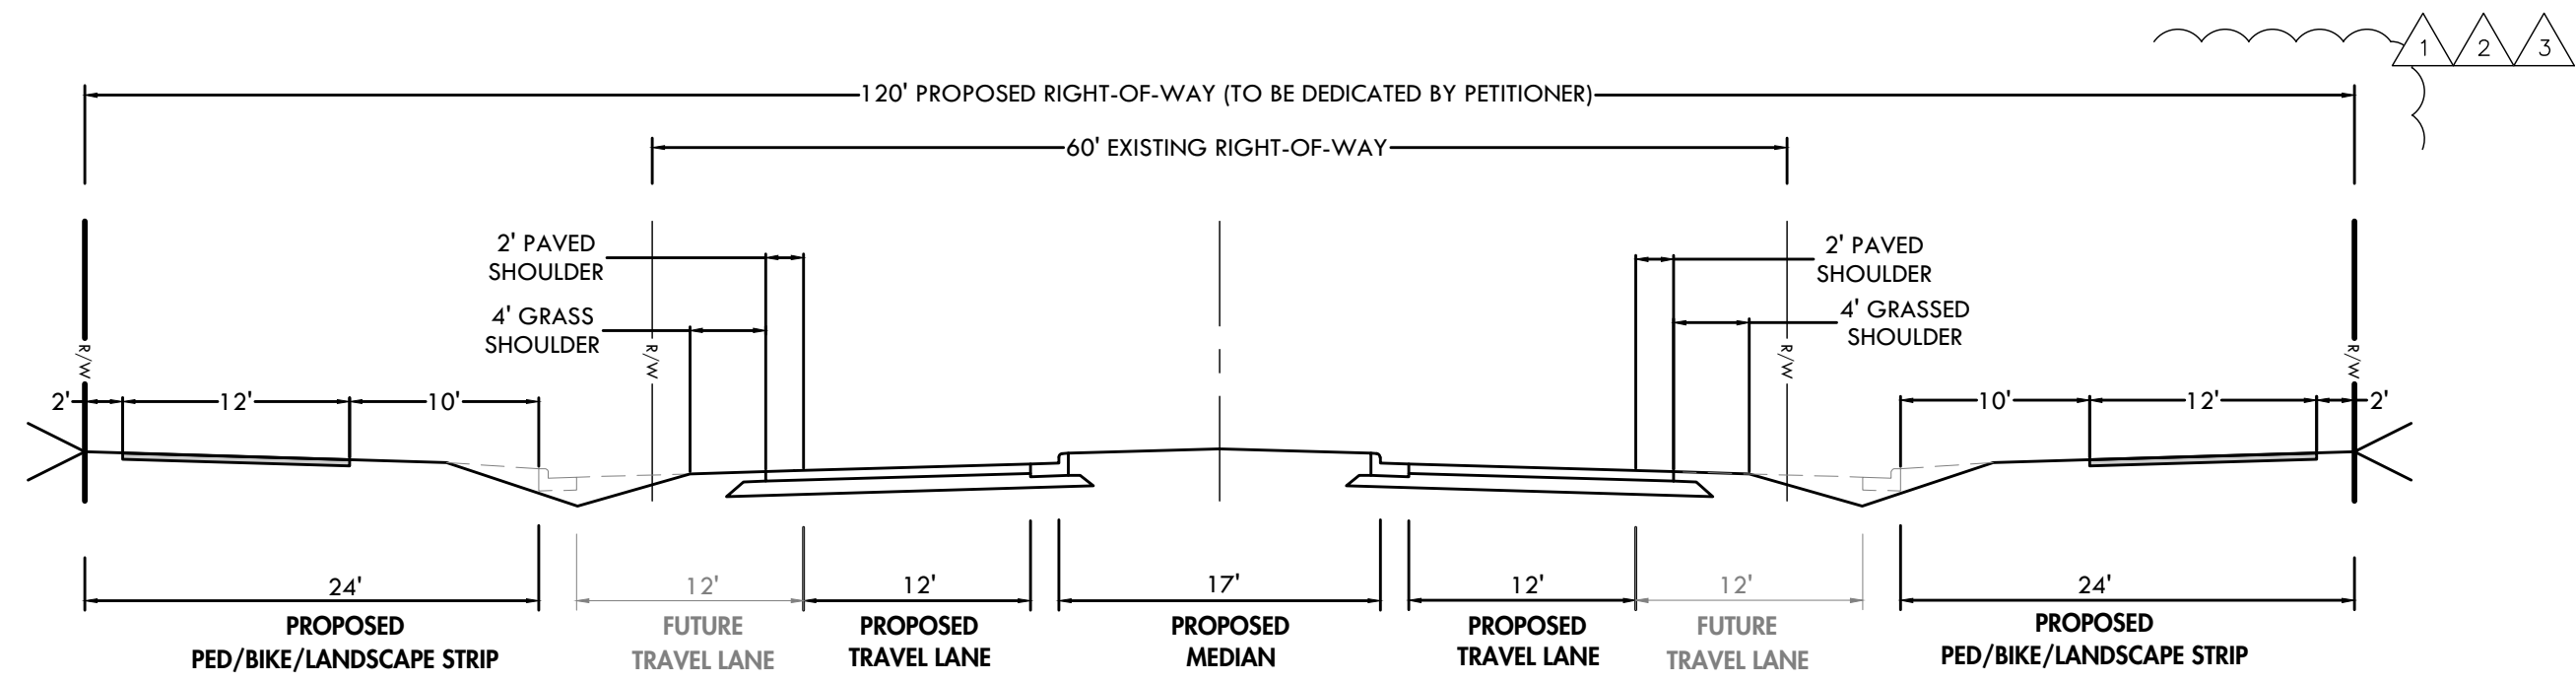


SECTION C - C  
PROPOSED ROAD IMPROVEMENTS  
(FUTURE BY OTHERS)

3 TYPICAL PAVEMENT SECTION FOR PROPOSED PUBLIC ROAD:

|                      |                                                                                                                                |
|----------------------|--------------------------------------------------------------------------------------------------------------------------------|
| SURFACE COURSE:      | PROPOSED 3.0 INCHES ASPHALT CONCRETE SURFACE COURSE, TYPE S9.5C, AT AN AVERAGE RATE OF 168 LB/SY IN EACH OF TWO 1.5-INCH LIFTS |
| INTERMEDIATE COURSE: | PROPOSED 4.0 INCHES (MIN) ASPHALT CONCRETE INTERMEDIATE COURSE, TYPE I19.0C, AT AN AVERAGE RATE OF 456 LB/SY                   |
| BASE COURSE:         | PROPOSED 8.0 INCHES ASPHALT CONCRETE BASE COURSE, TYPE B25.0C, AT AN AVERAGE RATE OF 399 LB/SY IN EACH OF TWO EQUAL LIFTS      |

NOTE: FOR ALL PUBLIC ROAD PAVEMENT SECTIONS TO BE CONSTRUCTED BY PETITIONER. CONSISTENT WITH CLDSM STANDARD DETAIL NUMBER 11.09.

PE SEAL:

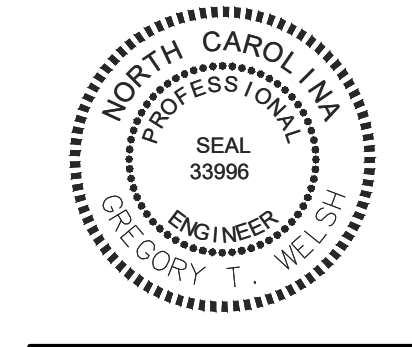

GARRISON ROAD INDUSTRIAL  
REZONING PETITION NUMBER 2019-173  
CHARLOTTE, NORTH CAROLINA  
MCCRANEY PROPERTY COMPANY  
PROPOSED GARRISON ROAD CROSS SECTIONS

- REVISIONS:
- 5/11/20 - CITY STAFF COMMENTS
  - 8/24/20 - CITY STAFF COMMENTS
  - 12/23/20 - CITY STAFF COMMENTS
  - 01/21/21 - COORDINATION W/ CRESCENT
  - 02/22/21 - COORDINATION W/ CRESCENT

ENGINEER: GTW  
DRAWN BY: ERT  
CHECKED BY: LJB  
PROJECT #: 019.039

SHEET  
RZ-4  
SHEET 4 OF 5

**Site Development Data:**

--Acreage: ± 153 acres  
--Tax Parcel #: 14129102, 14129105, 14118165, 14129101, 14129107, 14118119 and 14129103  
--Existing Zoning: R-3  
--Proposed Zoning: I-1(CD)  
--Existing Uses: Vacant/Residential  
--Permitted Uses: Warehousing, warehouse distribution, manufacturing, office, and all other industrial uses as permitted by right and under prescribed conditions together with accessory uses, all as allowed in the I-1 zoning district (as more specifically described in the Development Standards below).  
--Maximum Gross Square feet of Development: Up to 1,450,000 square feet of gross floor area  
--Maximum Building Height: Height as permitted by Ordinance and will be measured as defined by the Ordinance.  
--Parking: As required by the Ordinance for the permitted uses.

**I. General Provisions:**

a. **Site Location.** These Development Standards, Schematic Site Plan and other graphics set forth on Sheet RZ-1 and any other Sheets from this rezoning plan (collectively referred to as the "Rezoning Plan") associated with the Rezoning Petition filed by McCraney Property Company ("Petitioner") to accommodate the development of the requested permitted uses on the approximately 150 acre site located on Garrison Road (the "Site").

b. **Zoning Districts/Ordinance.** Development of the Site will be governed by the Rezoning Plan as well as the applicable provisions of the City of Charlotte Zoning Ordinance (the "Ordinance"). Unless the Rezoning Plan establishes more stringent standards, the regulations established under the Ordinance for the I-1 zoning classification shall govern all development taking place on the Site.

c. **Graphics and Alterations.** Any schematic depictions of the building envelopes, parking areas, sidewalks, driveways, streets, open space, buffers and other development matters and site elements (collective the "Development/Site Elements") set forth on the Rezoning Plan should be reviewed in conjunction with the provisions of the Development Standards. Any layouts, locations, sizes and formulations of the Development/Site Elements depicted on the Rezoning Plan are graphic representations of the Development/Site elements proposed. Changes to the Rezoning Plan not anticipated by the Rezoning Plan will be reviewed and approved as allowed by Section 6.207 of the Ordinance.

Since the project has not undergone the design development and construction phases, and the final roadway alignment for the future Garrison Road Extension and Catawba connector have not been finalized, it is intended that this Rezoning Plan provide for flexibility in allowing some alterations or modifications from the graphic representations of the Development/Site Elements. Therefore, there may be instances where minor modifications will be allowed without requiring

CHAR22197012v1

- 1 c. A fifty (50) foot Class A Buffer that can be reduced per Ordinance will be provided adjacent to those properties zoned MUDD-O as generally depicted on the Rezoning Plan.
- 1 2 d. A one hundred (100) foot Class A Buffer that can be reduced per Ordinance will be provided adjacent to those properties zoned MX-1 and designated as residential use as generally depicted on the Rezoning Plan.
- 1 2 e. A seventy-five (75) foot Class A Buffer that can be reduced per Ordinance will be provided adjacent to those properties zoned MX-1 and designated as non-residential use as generally depicted on the Rezoning Plan.
- 5 f. Petition commits to install supplemental landscaping along the Site's frontage on Garrison Road in addition to the required street trees.

**5. Architectural Standards and Design Guidelines.**

- a. **Building Materials.** The principal building(s) constructed on the Site may use a variety of building materials. The building materials used for buildings will be a combination of the following: glass, brick, stone, simulated stone, pre-cast stone, precast concrete, synthetic stone, stucco, cementitious siding (such as hard-plank), metal panels (on north and west elevations only), EIFS, cast on site concrete panel or wood. Vinyl as a building material will not be allowed except on windows and soffits.
- b. **Mechanical Equipment Screening.** HVAC and related mechanical equipment will be screened from public view and from view of adjacent properties and proposed public streets at grade.
- c. **Dumpster Screening.** Dumpster areas and recycling areas will be enclosed by a solid wall or fence.
- d. **Pedestrian Entrances.** There shall be a minimum of one street facing entrance to each public street. Corner entrances shall meet this requirement for both streets. All pedestrian entrances, excluding emergency exits, will be architecturally defined with glazing, awnings, canopies and/or other architectural element, and have a connection to adjacent Public Streets.

**6. Environmental Features:**

- a. The Site shall comply with the Charlotte City Council approved and adopted Post Construction Controls Ordinance.
- b. The Site will comply with Tree Ordinance.
- c. Stream Buffers shall comply with the Lower Lake Wylie Watershed Overlay Ordinance.
- d. 100' SWIM/PCSO Stream Buffers shall be increased to include 50% of the flood fringe area as additional stream buffer. Delineation of the additional stream buffer area will be deferred to the permitting process.

the Administrative Amendment Process per Section 6.207 of the Ordinance. These instances would include changes to graphics if they are:

- i. minor and don't materially change the overall design intent depicted on the Rezoning Plan; such as minor modifications to the configurations of any building envelope, driveways and parking area dimensions and the like as long as the modifications maintain the general building/parking orientation and character of the development generally depicted on the Rezoning Plan.

The Planning Director will determine if such minor modifications are allowed per this amended process, and if it is determined that the alteration does not meet the criteria described above, the Petitioner shall then follow the Administrative Amendment Process per Section 6.207 of the Ordinance; in each instance, however, subject to the Petitioner's appeal rights set forth in the Ordinance.

d. **Planned/Unified Development.** The Site shall be viewed in the aggregate as a planned/unified development plan as to the elements and portions of the Site generally depicted on the Rezoning Plan. As such, side and rear yards, buffers, building height separation standards, and other similar zoning standards will not be required internally between improvements and other site elements located on the Site. The Petitioner and/or owner(s) of the Site reserve the right to subdivide the portions or all of the Site and create lots within the interior of the Site without regard to any such internal separation standards, and public/private street frontage requirements, provided, however, all such separation standards along the exterior boundary of the Site shall be adhered to and all square footage maximum requirements will be regulated by any development limitations set forth in Section 2 below as to the Site taken as a whole and not individual portions or lots located therein.

e. **Number of Buildings Principal and Accessory.** Notwithstanding the number of building(s) shown on the Rezoning Plan, the total number of principal buildings to be developed on the Site will be limited to seven (7). Accessory buildings and structures located on the Site shall not be considered in any limitation on the number of buildings on the Site. Accessory buildings and structures will be constructed utilizing similar building materials, colors, architectural elements and designs as the principal building(s). In the event more than one principal building is developed on the Site, the Site shall adhere to the Subdivision Ordinance.

**2. Permitted Uses, Development Area Limitations:**

a. The Site may be developed with up to **1,450,000** square feet gross floor area of warehousing, warehouse distribution, manufacturing, office, and all other industrial uses as permitted by right and under prescribed conditions together with accessory uses, as allowed in the I-1 zoning district.

*For purposes of the development limitations set forth in these Development Standards (but not to be construed as a limitation on FAR requirements), the following items will not be counted as part of the allowed gross floor area (floor area as defined by the Ordinance) for the Site: structured parking facilities and all loading dock areas (open or enclosed).*

- 1 e. The location, size, and type of storm water management systems depicted on the Rezoning Plan are subject to review and approval as part of the full development plan submittal and are not implicitly approved with this rezoning. Adjustments may be necessary in order to accommodate actual storm water treatment requirements and natural site discharge points.
- f. Development within any SWIM/PCSO Buffer shall be coordinated with and subject to approval by Charlotte-Mecklenburg Storm Water Services and mitigated if required by City ordinance. Petitioner acknowledges intermittent/perennial stream delineation reports are subject to review and approval upon submission of development plans for permitting and are not approved with rezoning decisions.
- g. Prior to submission of any civil site plan for development, the developer agrees to survey all identified jurisdictional wetlands and streams within the assemblage. Stream buffers will be accurately shown, measured from the surveyed tops of banks.
- h. With regard to temporary sediment basin design, the Petitioner commits to basin sizing on storm events detaining the 2-year storm for five (5) days and the 25 year storm for three (3) days while routing the 50 year storm through the water quality skimmer outlet.
- i. Additional specific measures to be employed in concert with the increased basin capacity will include that all plans follow the requirements of the Critical and Protected Area Enhanced Erosion Control Measures Checklist, including polyacrylamide (PAM) plans. PAM shall be specified for use with seeding mixtures and to treat sheet flow runoff to basins including type, amount, and frequency of application.
- j. The Petitioner shall work with the City Water Quality Administrator or designee to provide increased temporary basin capacity and to implement other erosion control measures based on earthwork cut/fill analysis.
- k. Good faith efforts will be made to follow the additional Design and Site Management Considerations included in the Critical and Protected Area Enhanced Erosion Control Measures Checklist.
- l. A qualified individual will be dedicated solely to the protection of surface water resources with duties to include the periodic inspection of erosion control measures and land disturbing activities, the routine inspection of surface waters, and activities necessary to ensure the compliance with water quality regulations and rezoning conditions.
- m. A copy of the EEP easement for the Beaverdam Creek Restoration Project will be provided at the time of construction plan submission and all provisions of the EEP easement will be followed as it pertains to the assemblage.
- n. The Petitioner agrees to coordinate Greenway Connectivity to the adjacent Berewick Regional Park with the River District and Mecklenburg County Parks and Recreation.
- 2 o. The Petitioner agrees to provide continuous monitoring devices downstream to monitor turbidity 24 hours/day during construction and provide alerts to erosion control inspectors if exceedances occur.

**3. Transportation Improvements and Access:**

a. The transportation improvements, pedestrian improvements and right of way dedication described below in paragraphs 3.a(1), 3.a(2) and 3.a(3) shall be constructed, installed, and dedicated by the Petitioner.

(1) The Petitioner will provide access to the Site as generally depicted on the Rezoning Plan, via extending Garrison and subject to the provisions below; provided that the exact alignment, dimensions and location of the access point to the Site and the driveway on the Site may be modified from the elements shown on the Rezoning Plan as long as the overall design intent is not materially altered and requirements described in this Section 3 are met.

(2) Planting strips and sidewalks shall be constructed in accordance with the final construction plans associated with the Extension of Garrison Road.

(3) Transportation improvements will be phased by the Petitioner to support the build out of the Site. The Petitioner shall install the following transportation improvements as generally depicted on the rezoning plan:

**a. Phase One:**

- i. Petitioner shall grant to CDOT a 120-foot right-of-way where the petitioner controls both sides of Garrison Road (or 60-feet of right-of-way measured from the centerline where the petitioner only controls one side of Garrison Road), as generally depicted on the attached rezoning plan.
- ii. Petitioner shall design a 4 lane and construct a 2 lane, median-divided section of Garrison Road from Dixie River Road and extending north to the intersection of Garrison Road and the future "Catawba Crossing".

**b. Phase Two:**

- i. Petitioner shall design and construct a 3-lane section, expandable to 4 lanes along the petitioner-controlled frontage north of the future "Catawba Crossing" as generally depicted on the rezoning plans.
- ii. Upon successful acquisition of 60' right-of-way, that portion of Garrison Road located north of the subject property shall be widened to two 12-foot lanes with a 2-foot shoulder from the subject property to West Boulevard as shown on the attached Rezoning Plan.
- iii. Petitioner shall have the option to widen that portion of Garrison Road to Horton Road as described above IF the West Boulevard / Garrison Road improvements to be constructed by the developer of the River District are not completed prior to issuance of the final building's Certificate of Occupancy.
- iv. Prior to receiving the Certificate of Occupancy for 50% of the allotted square-footage, the petitioner shall increase the storage capacity of the right turnlane of the I-485 Outer Exit Ramp from 140' to 175' as described in the Traffic Impact Study. **This improvement shall be waived IF the River District's Garrison Road / West Boulevard Improvements are completed.**

- 2 p. The Petitioner agrees to participate in annual bathymetric monitoring of Browns' Cover (currently being led by the River District).
- 3 q. Prior to the issuance of a certificate of occupancy for the second new building constructed on the site, Petitioner shall dedicate and convey to Mecklenburg County for future greenway purposes the entire 100 year floodplain on the site (the "Greenway Area"). Prior to the dedication and conveyance of the Greenway Area to Mecklenburg County, Petitioner shall have the right to install and locate utility lines through such Greenway Area and to reserve such easements over such Greenway Area that are necessary to maintain, repair and replace such utility lines, and to reserve such other easements as may be reasonably necessary in connection with the development of the site as long as these easements and utility lines do not interfere with the construction and maintenance of the greenway by Mecklenburg County. Any easements must be reviewed by Mecklenburg County prior to the dedication and conveyance of the Greenway Area to Mecklenburg County.
- r. The area of the site located within the Greenway Area shall be considered when calculating the allowed density on the Site.
- s. The trees located within the Greenway Area shall count towards the site's minimum tree save requirements. The Greenway Area shall count towards the site's required open space.
- t. Notwithstanding the foregoing, in the event that Mecklenburg County does not approve and accept the dedication and conveyance of the Greenway Area, then the Greenway Area shall be a part of the Site's tree save and/or open space areas.

**7. Lighting:**

a. All new lighting shall be full cut-off type lighting fixtures excluding lower, decorative lighting that may be installed along the driveways, sidewalks, and parking areas.

**8. Amendments to the Rezoning Plan:**

a. Future amendments to the Rezoning Plan (which includes these Development Standards) may be applied for by the then Owner or Owners or applicable parcels within the Site in accordance with the provisions herein and of Chapter 6 of the Ordinance.

**9. Binding Effect of the Rezoning Application:**

a. If this Rezoning Petition is approved, all conditions applicable to the development of the Site imposed under the Rezoning Plan will, unless amended in the manner provided herein and under the Ordinance, be binding upon and inure to the benefit of the Petitioner and subsequent owners of the Site or Development Areas, as applicable, and their respective heirs, devisees, personal representatives, successors in interest or assigns.

- 1 b. The transportation and pedestrian improvements described in Section 3(a)(3)a "Phase One" shall be substantially completed prior to the issuance of the first certificate of occupancy for the first upfit within a building shell on the Site.
- 2 c. The foregoing public roadway improvements described in Section 3 will be subject to the thoroughfare roadway design standards and criteria of CDOT, NCDOT and the Charlotte Fire Department as applicable. Reference to "substantial completion" or "substantially completed" for improvements as set forth in the provisions above shall mean completion of the roadway improvements in accordance with the above standards provided, however, in the event all such roadway improvements are not completed at the time that the Petitioner seeks to obtain a certificate of occupancy for building(s) on the Site or in connection with any development phasing, then the Petitioner will work with City Staff to determine a process to allow the issuance of certificates of occupancy for the applicable building(s), and in such event the Petitioner may be asked to post a letter of credit or a bond for any improvements not in place at the time such a certificate of occupancy is issued to secure completion of the applicable improvements.
- 3 d. Changes to the above referenced roadway improvements in this Section 3 can be approved through the Administrative Amendment process upon the determination and mutual agreement of Petitioner, CDOT, and the Planning Director as applicable, provided, however, the proposed alternate transportation improvements provide (in the aggregate) comparable transportation network benefits to the improvements identified in this Petition.
- 4 e. The Petition shall dedicate and convey (fee simple) to the City the rights of way within both phases described in Paragraph (3) before the site's first building certificate of occupancy is issued for each respective phase. Rights of way shall be set 2' behind back of sidewalk where feasible.
- f. The pavement sections for the public roads that will be constructed by the petitioner shall be consistent with CLDSM Standard Detail Number 11.09.
- g. The Petitioner shall construct left-turn lanes, with appropriate storage and bay tapers, within the center median at the proposed access points for Development Areas B, C, and D within Phase 1. Where feasible and as approved by CDOT during the plan review, the Petitioner shall align opposing driveways and/or condense the number of proposed access points on Garrison Road, to minimize the number of required left-turn lane bays.
- h. Final design details will be determined during the permit review process and will include input from other departments including but not limited to CDOT, General Services, Charlotte Fire Department, and the NCDOT.
- i. The proposed cross sections shown shall comply with all applicable ordinance requirements in addition to what is shown.

**4. Setbacks, Buffers and Screening.**

- a. A twenty (20) foot setback shall be provided as defined by Ordinance from public streets.
- b. A one hundred (100) foot Class A Buffer that can be reduced per Ordinance will be provided adjacent to the single-family homes as generally depicted on the Rezoning Plan.

**REVISIONS:**

1. 5/11/20 - CITY STAFF COMMENTS  
2. 8/24/20 - CITY STAFF COMMENTS  
3. 12/23/20 - CITY STAFF COMMENTS  
4. 02/22/21 - COORDINATION W/ CRESCENT

PE SEAL:

