

REZONING PETITION
FOR PUBLIC HEARING
2019-078

REZONING PETITION

JOHNSTON OEHLER SITE

CHARLOTTE, NORTH CAROLINA
ARTER PROPERTIES, INC.
1520 SOUTH BOULEVARD, SUITE 215
CHARLOTTE, NC 28203
704 377 4172


SCHEMATIC SITE PLAN


PROJECT #: 278-033
DRAWN BY: JO

MAY 2, 2010

REVISIONS:

RZ1.0

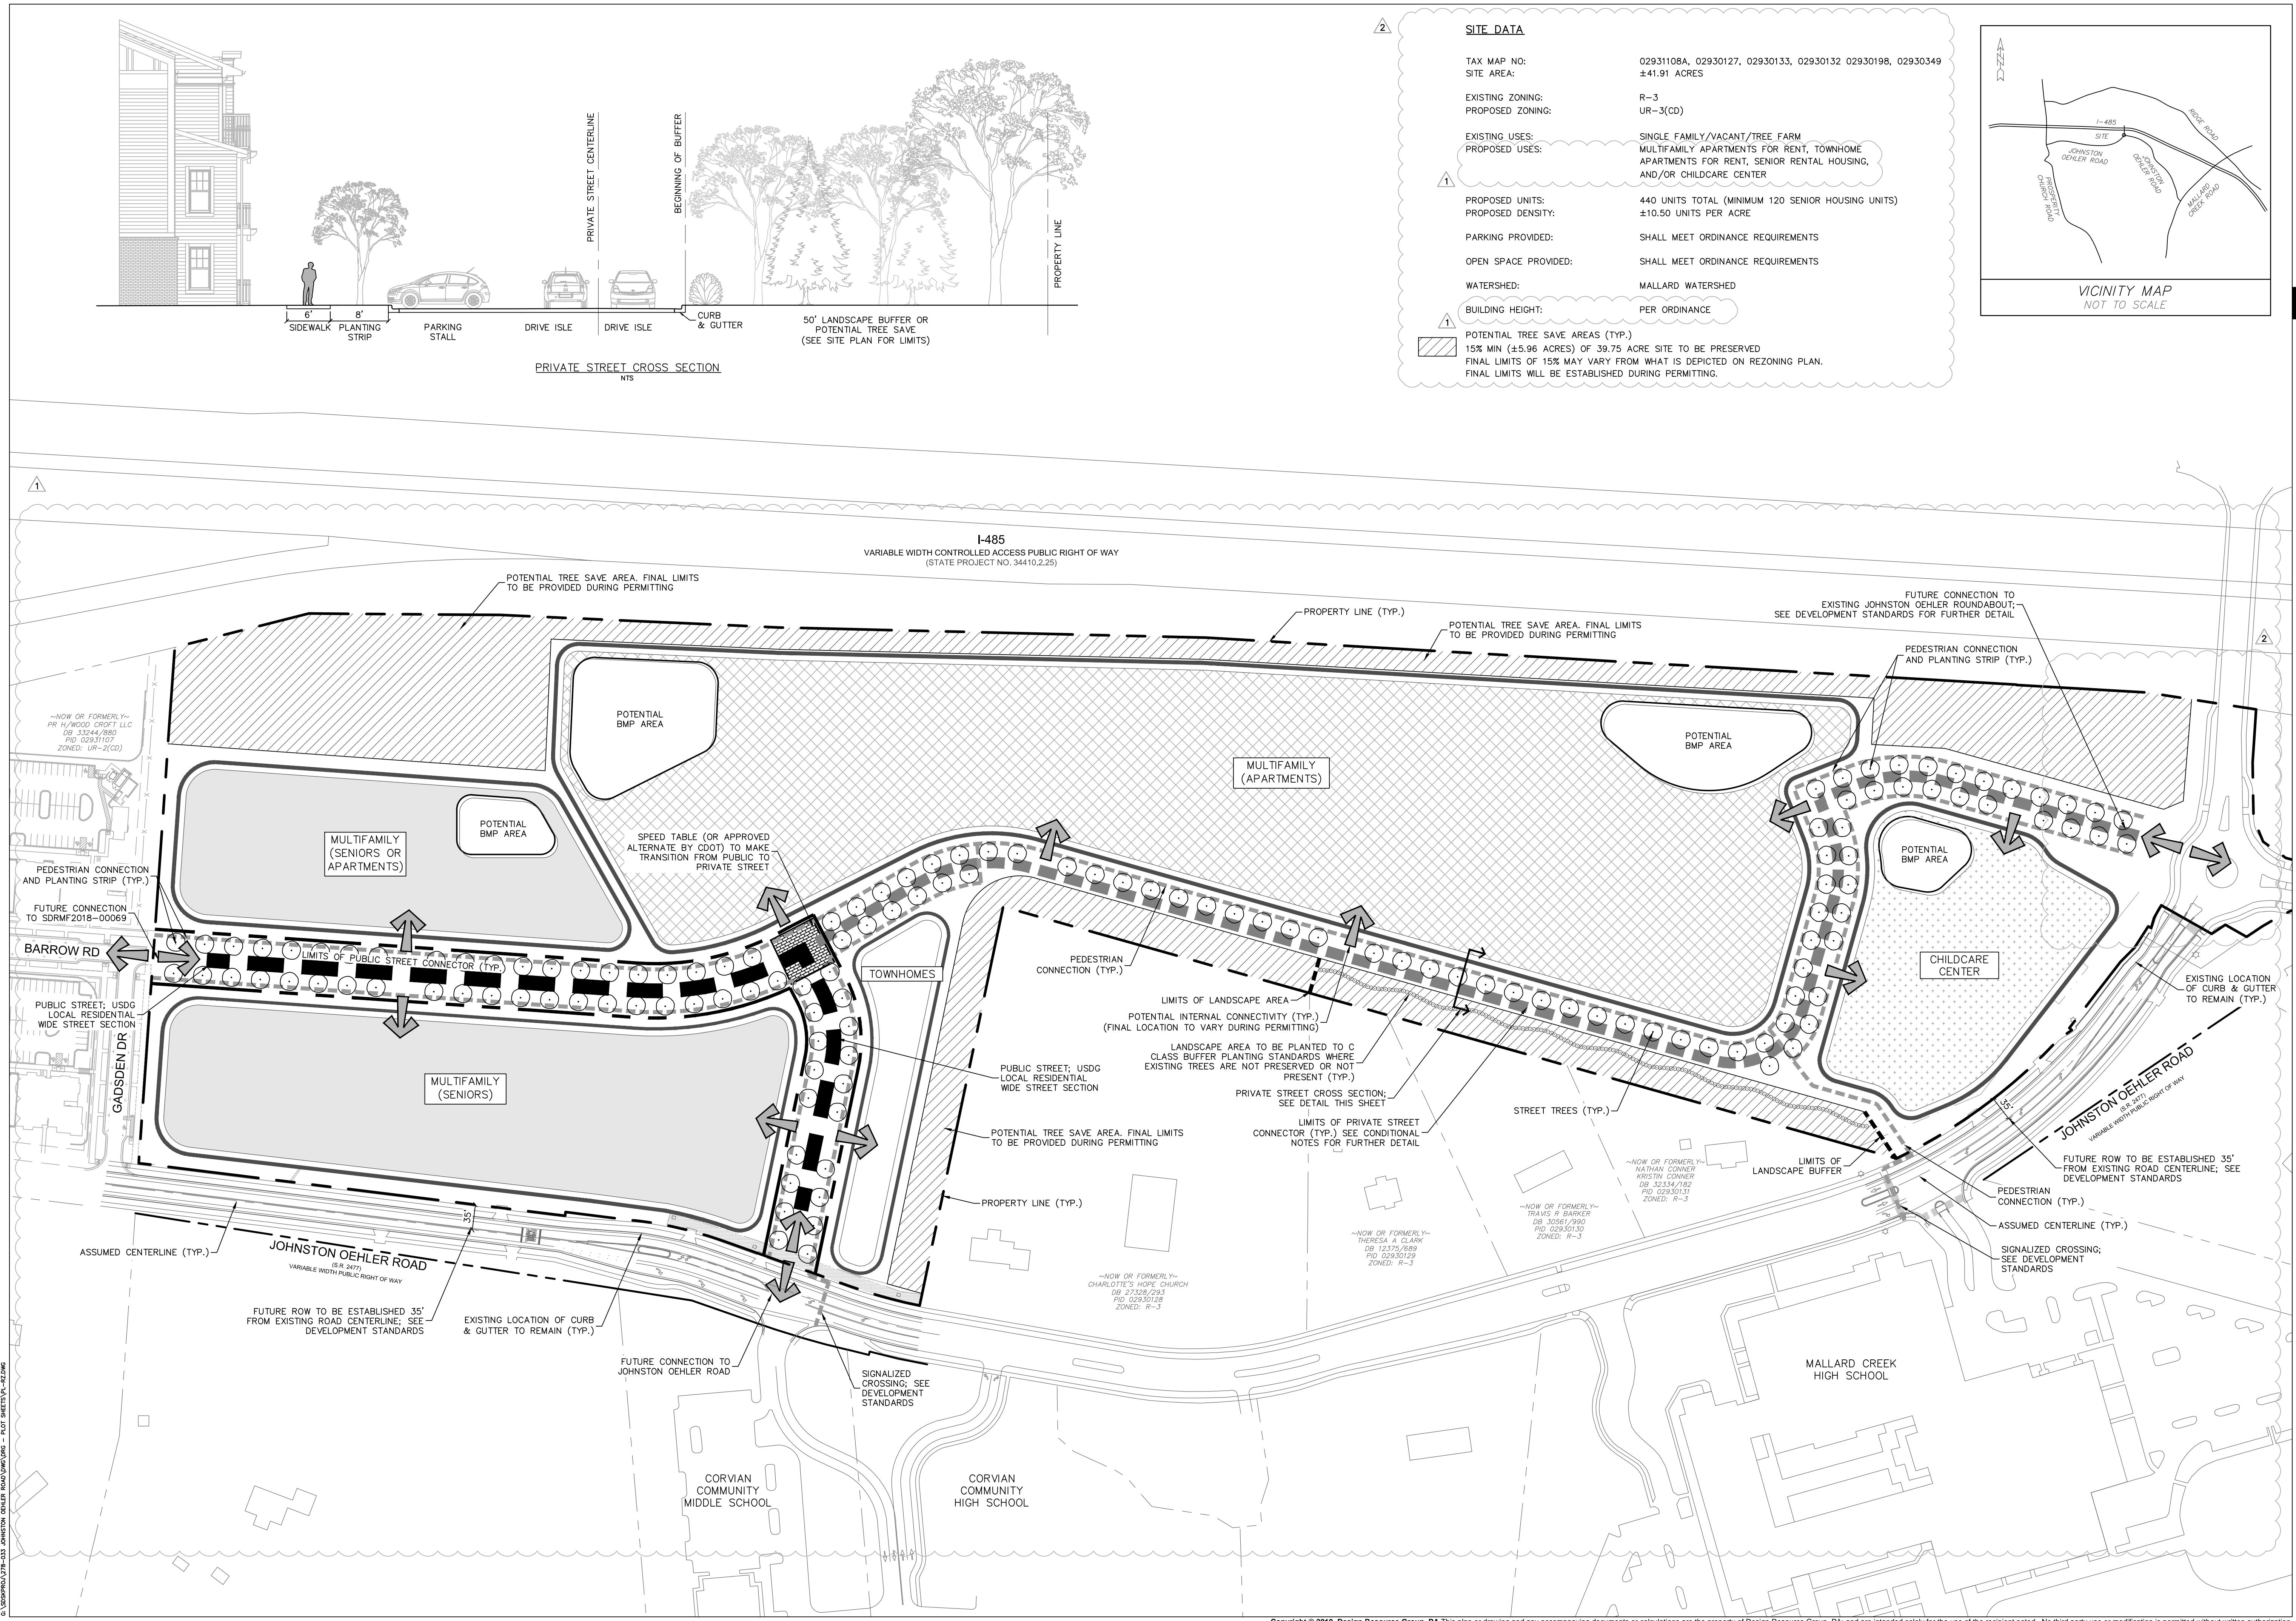

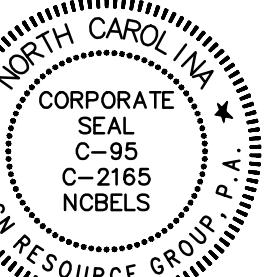

REZONING PETITION
FOR PUBLIC HEARING

2019-078

REZONING PETITION

JOHNSTON OEHLER SITE
CHARLOTTE, NORTH CAROLINA

1520 SOUTH BOULEVARD, SUITE 215
CHARLOTTE, NC 28203

704.377.4172

TECHNICAL
DATA SHEET

PROJECT #: 278-033
DRAWN BY: JO
CHECKED BY: NB

MAY 3, 2019

REVISIONS:
1. 08.12.19 PER REVIEW COMMENTS
2. 09.12.19 PER SITE UPDATES
3. 10.25.19 PER SITE UPDATES

2

SITE DATA

TAX MAP NO: 02931108A, 02930127, 02930133, 02930132 02930198, 02930349
SITE AREA: ±41.91 ACRES

EXISTING ZONING: R-3
PROPOSED ZONING: UR-3(CD)

EXISTING USES: SINGLE FAMILY/VACANT/TREE FARM
PROPOSED USES: MULTIFAMILY APARTMENTS FOR RENT, TOWNHOME
APARTMENTS FOR RENT, SENIOR RENTAL HOUSING,
AND/OR CHILDCARE CENTER


PROPOSED UNITS: 440 UNITS TOTAL (MINIMUM 120 SENIOR HOUSING UNITS)
PROPOSED DENSITY: ±10.50 UNITS PER ACRE

PARKING PROVIDED: SHALL MEET ORDINANCE REQUIREMENTS

OPEN SPACE PROVIDED: SHALL MEET ORDINANCE REQUIREMENTS

WATERSHED: MALLARD WATERSHED

BUILDING HEIGHT: PER ORDINANCE

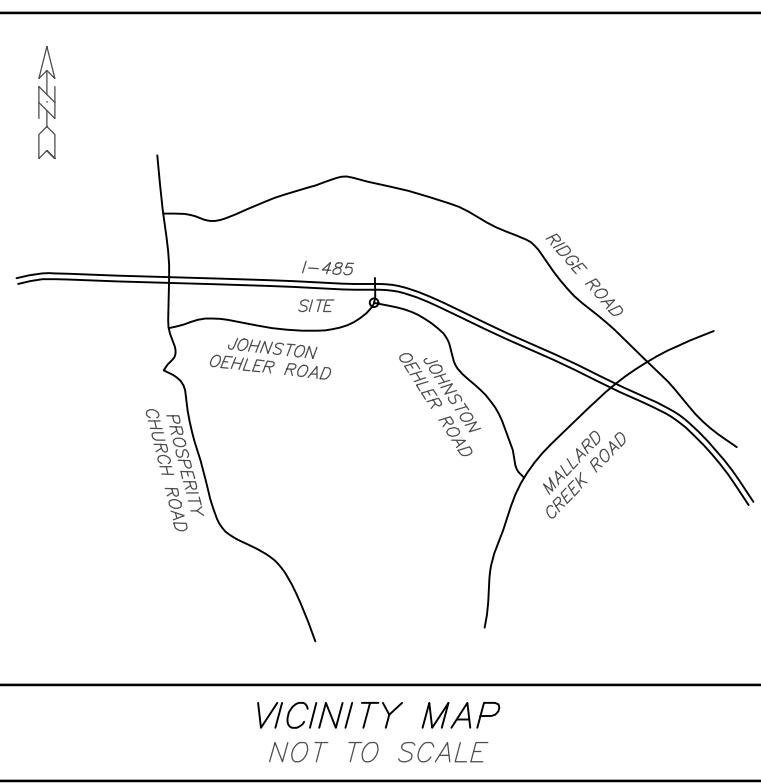

VICINITY MAP
NOT TO SCALE

DEVELOPMENT STANDARDS

GENERAL PROVISIONS:

a. DEVELOPMENT OF THE SITE WILL BE CONTROLLED BY THE STANDARDS DEPICTED ON THIS TECHNICAL DATA SHEET (SITE PLAN) AND BY THE STANDARDS OF THE CITY OF CHARLOTTE. THE DEVELOPMENT DEPICTED ON THIS SITE PLAN IS INTENDED TO REFLECT THE ARRANGEMENT OF PROPOSED USES ON THE SITE, BUT THE EXACT CONFIGURATION, PLACEMENT, AND SIZE OF INDIVIDUAL SITE ELEMENTS MAY BE ALTERED OR MODIFIED WITHIN THE LIMITS PRESCRIBED BY THE ORDINANCE DURING THE DESIGN DEVELOPMENT AND CONSTRUCTION PHASES AS ALLOWED UNDER THE PROVISIONS OF SECTION 6.2 OF THE ZONING ORDINANCE.

b. THE PETITIONER ACKNOWLEDGES THAT OTHER STANDARD DEVELOPMENT REQUIREMENTS IMPOSED BY OTHER CITY ORDINANCES, SUCH AS THOSE THAT REGULATE STREETS, SIDEWALKS, TREES, CYCLE PARKING, AND SITE DEVELOPMENT, MAY APPLY TO THE DEVELOPMENT OF THIS SITE. THESE ARE NOT ZONING REGULATIONS, ARE NOT ADMINISTERED BY THE ZONING ADMINISTRATOR, AND ARE NOT SEPARATE ZONING CONDITIONS IMPOSED BY THIS SITE PLAN, UNLESS SPECIFICALLY NOTED IN THE CONDITIONS FOR THIS SITE PLAN. THESE OTHER STANDARD DEVELOPMENT REQUIREMENTS WILL BE APPLIED TO THE DEVELOPMENT OF THIS SITE AS DEFINED BY THOSE OTHER CITY ORDINANCES.

c. THROUGHOUT THIS REZONING PETITION, THE TERMS "OWNER", "OWNERS", "PETITIONER" OR "PETITIONERS", SHALL, WITH RESPECT TO THE SITE, BE DEEMED TO INCLUDE THE HEIRS, DEVISEES, PERSONAL REPRESENTATIVES, SUCCESSORS IN INTEREST AND ASSIGNEES OF THE OWNER OR OWNERS OF THE SITE WHO MAY BE INVOLVED IN ITS DEVELOPMENT FROM TIME TO TIME.

PURPOSE:

THE PURPOSE OF THIS PETITION IS TO PROVIDE FOR THE DEVELOPMENT OF A MIXED-USE COMMUNITY WITH SENIOR HOUSING, MULTIFAMILY HOUSING, AND A CHILDCARE CENTER. TO ACHIEVE THIS PURPOSE, THE APPLICATION SEEKS TO REZONE THE SITE TO THE UR-3(CD) CLASSIFICATION.

PERMITTED USES:

USES ALLOWED ON THE PROPERTY INCLUDED IN THIS PETITION WILL BE SENIOR HOUSING, MULTIFAMILY DWELLING HOUSING, A CHILDCARE CENTER, AND RELATED ACCESSORY USES AS ARE PERMITTED IN THE UR-3 DISTRICT.

INCIDENTAL AND ACCESSORY USES FOR THE MULTIFAMILY APARTMENT PORTION OF THE SITE MAY INCLUDE WITHOUT LIMITATION, A LEASING AND MANAGEMENT OFFICE, AND AMENITIES SUCH AS A FITNESS CENTER, MAIL KIOSK/PACKAGE DELIVERY AREA, CLUBHOUSE, SWIMMING POOL, DOG PARK, PLAYGROUND, POCKET PARK AND OUTDOOR GILL AND GATHERING AREAS.

TRANSPORTATION:

a. THE SITE WILL HAVE A PUBLIC STREET CONNECTION TO BARROW RD ON WEST SIDE OF THE SITE AND A PUBLIC STREET CONNECTION TO JOHNSTON OEHLER RD ALONG THE SOUTH SIDE OF THE SITE TO LINE UP WITH THE EXISTING CORVIAN COMMUNITY MIDDLE SCHOOL DRIVEWAY AS DEPICTED ON THE REZONING PLAN.

b. THE SITE WILL HAVE ACCESS VIA A DRIVEWAY TO JOHNSTON OEHLER ROAD TRAFFIC CIRCLE ON EASTERN SIDE OF SITE VIA PRIVATE STREET CONNECTION. CONNECTION TO TRAFFIC CIRCLE PENDING FINAL PARCEL ACQUISITION FROM THE CITY OF CHARLOTTE (TAX PARCEL# 02930349)

c. PARKING AREAS ARE GENERALLY INDICATED ON THE REZONING PLAN FOR THE SITE.

d. THE FUTURE RIGHT OF WAY OF JOHNSTON OEHLER RD SHALL BE ESTABLISHED 35' FROM EXISTING ROAD CENTERLINE ALONG THE SITES FRONTRAGE TO THE EXTENT THAT SUCH RIGHT OF WAY DOES NOT EXIST.

e. THE LIMITS OF THE PRIVATE ROAD ONSITE AS SHOWN ON THE REZONING PLAN SHALL HAVE A PUBLIC ACCESS EASEMENT. NO GATES WILL BE PERMITTED ALONG THIS PRIVATE ROAD.

f. A PEDESTRIAN CONNECTION SHALL BE PROVIDED ON THE EAST SIDE OF THE SITE CONNECTING THE INTERNAL PRIVATE STREET TO THE JOHNSTON OEHLER ROAD SIDEWALK ACROSS FROM MALLARD CREEK HIGH SCHOOL AS DEPICTED ON THE REZONING PLAN. THE EXACT LOCATION OF THIS PEDESTRIAN CONNECTION SHALL BE DETERMINED DURING PERMITTING AND MAY VARY FROM WHAT IS DEPICTED ON THE REZONING PLAN.

g. INSTALLATION OF AN EAST BOUND LEFT TURN LANE ON JOHNSTON OEHLER RD FOR THE PUBLIC STREET DRIVEWAY ACCESS OPPOSITE OF THE CORVIAN MIDDLE SCHOOL AS NOTED ON THE REZONING PLAN.

h. UPGRADING CONSTRUCTION OF SIDEWALK RAMPS AND ACCESSIBLE PEDESTRIAN SIGNALS AT THE INTERSECTIONS OF JOHNSTON OEHLER RD AND PROSPERITY CHURCH RD. PEDESTRIAN RAMP AND PEDESTRIAN SIGNAL UPDATES ARE ONLY FOR PEDESTRIAN ACCOMMODATIONS THAT HAVE NOT BEEN RECENTLY UPDATED TO LATEST ACCEPTABILITY STANDARDS. PETITIONER IS RESPONSIBLE FOR IMPROVEMENTS THAT CAN BE ACHIEVABLE AND CONSTRUCTED WITHIN THE EXISTING RIGHT-OF-WAY LIMITS DIRECTLY RELATED TO INTERSECTION.

i. INSTALLATION OF A SIGNALIZED PEDESTRIAN CROSSING ON JOHNSTON OEHLER RD IN FRONT OF MALLARD CREEK HIGH SCHOOL AS DEPICTED ON REZONING PLAN. FINAL ALLOWANCE TO BE DETERMINED BY CDOT DURING PERMITTING.

k. INSTALLATION OF A SIGNALIZED PEDESTRIAN CROSSING ON JOHNSTON OEHLER RD IN FRONT OF THE CORVIAN COMMUNITY SCHOOLS AS DEPICTED ON REZONING PLAN. FINAL ALLOWANCE TO BE DETERMINED BY CDOT DURING PERMITTING.

l. THE PETITIONER SHALL DEDICATE FEES SIMPLE OF ALL RIGHTS-OF-WAY TO THE CITY BEFORE THE SITES FIRST BUILDING CERTIFICATE OF OCCUPANCY IS ISSUED. THE RIGHTS-OF-WAY SHALL BE SET 2' BEHIND BACK OF SIDEWALK ALONG PUBLIC STREETS WHERE FEASIBLE. A SIDEWALK UTILITY EASEMENT WILL BE UTILIZED IN LOCATIONS WHERE RIGHT-OF-WAY IS NOT ESTABLISHED 2' BEHIND PUBLIC SIDEWALKS.

m. ALL TRANSPORTATION IMPROVEMENTS WILL BE APPROVED AND CONSTRUCTED PRIOR TO THE SITE'S FIRST CERTIFICATE OF OCCUPANCY IS ISSUED ON THE PORTION OF THE REZONING PLAN LABELED MULTIFAMILY (APARTMENTS).

ARCHITECTURAL STANDARDS:
THE DEVELOPMENT OF THE SITE WILL BE GOVERNED BY THE DISTRICT REGULATIONS OF THE ZONING ORDINANCE FOR THE UR-3 DISTRICT AND BY THE FOLLOWING STANDARDS.

a. PREFERRED EXTERIOR BUILDING MATERIALS: WITH RESPECT TO EACH PRINCIPAL AND ACCESSORY BUILDING THAT ABUTS A NETWORK REQUIRED PUBLIC OR PRIVATE STREET, THE FAÇADE OF SUCH BUILDING THAT FACES SUCH NETWORK STREET SHALL CONTAIN A MINIMUM OF 20% BRICK, NATURAL STONE (OR ITS SYNTHETIC EQUIVALENT), STUCCO OR OTHER MATERIAL APPROVED BY THE PLANNING DIRECTOR.

b. PROHIBITED EXTERIOR BUILDING MATERIALS:
(i) VINYL SIDING (BUT NOT VINYL HAND RAILS, WINDOWS, SOFFITS, DOORS OR DOOR TRIM).
(ii) CONCRETE MASONRY UNITS NOT ARCHITECTURALLY FINISHED.

c. BUILDING PLACEMENT AND SITE DESIGN SHALL FOCUS ON AND ENHANCE THE PEDESTRIAN ENVIRONMENT THROUGH THE FOLLOWING:
(i) BUILDINGS SHALL BE PLACED SO AS TO PRESENT A FRONT OR SIDE FAÇADE TO ALL NETWORK REQUIRED STREETS (PUBLIC OR PRIVATE).
(ii) BUILDINGS SHALL FRONT A MINIMUM OF 50% OF THE TOTAL NETWORK REQUIRED STREET FRONTRAGE (EXCLUSIVE OF DRIVEWAYS, PEDESTRIAN ACCESS POINTS, ACCESSIBLE OPEN SPACE, TREE SAVE OR NATURAL AREAS, TREE REPLANTING AREAS AND STORM WATER FACILITIES).
(iii) PARKING LOTS SHALL NOT BE LOCATED BETWEEN ANY NETWORK REQUIRED PUBLIC OR PRIVATE STREET AND A BUILDING.