

or more of the following potential components: 1. Enhanced plantings in excess of minimum planting standards required of the ordinance (this may be enhanced landscape

f. Public open space shall be a dynamic and programmable open space centrally accessible to neighborhood residents that provide a layering of activities designed for multiple users. To accomplish this, the design of the open space shall consist of four (4)

yards, tree save, etc.). Enhanced plantings may also take the form of trees and/or planting beds (standard, raised and/or terraced with native species). Enhanced planting will include a minimum of 18 trees per one acre of common and public open space . Specialty paving materials (not including standard finished concrete or asphalt). Primary or accent building materials may be used as specialty paver options. Alternate concrete finishing (etching, salt curing, board forming, etc.) is acceptable.

3. Shading elements such as shade structures or additional trees planted in a manner to provide consistent shade in the space. 4. Seating options that include moveable tables and chairs. Other seating elements to be considered include seating walls, swings or interactive furniture, and immovable benches. Seating requirements for publicly accessible open space shall be provided at 1

linear foot of seating per 300 square feet of public open space. Seating shall be a mixture of moveable and fixed. Public open space will have a minimum dimension of 50 feet or more measured in all directions and common open space will have a minimum dimension of 20 feet or more measured in all directions.

6. Public art/sculpture. Public art, either in the form of murals, sculpture, or other mediumsalongside the details of the art intervention (inclusive of type, size, and location) shall be provided during land development review. The petitioner may use the City of Charlotte's Creative Artist Pool to utilize for implementing any public art.

7. Interactive elements that users the enjoyment of sensory stimulation. These elements should include but not be limited to Decorative lighting elements that include uplighting of trees or other open space elements and additional ambient lighting elements to enhance the experience of the space. When this element is utilized, the petitioner shall provide a lighting plan to plan

review staff that provides details/technical notes on the element along with the location of installation. 9. At least one common open space area shall be accessible from all residential lots in the residential development within a 1,000-foot radius of the common open space area. This radius is measured in a straight line from the lot line, without regard for street, sidewalk or trail connections, to the nearest point of the open space. Multiple common open space areas may be needed to

## 5. General Design Guidelines:

meet this requirement.

a. The residential buildings on the Site will comply with the applicable residential site layout, building design standards, and building material restrictions found in Article 5 of the Ordinance. When a building abuts both a frontage and common open space and the building fronts along the common open space as permitted per Article 5.3.G, the general design guidelines of this section will apply to the facades of the buildings fronting the common open space

c. The facades of the buildings abutting public streets and internal network required streets will not have blank walls that exceed

b. Windows, doors, porches, stoops, or other architectural features are required on all frontage-facing facades to avoid the appearance of blank walls. All ground floor entrances to individual units on a frontage with a sidewalk shall be between 1' and 5' above or below the grade of the adjacent sidewalk when located within 10' of the back of sidewalk. If porches are provided, they shall be covered and be at least six (6) feet depth. If stoops are provided, they shall be at least three (3) feet deep and may be covered.

twenty (20) feet in length on all building levels. Windows will be provided on these facades abutting public streets and internal network required streets in order to accommodate a minimum 25% transparency on the ground floor and 15% transparency on the upper floors to avoid blank walls.

. Vinyl shall be limited to no more than 25% of each building facade along a frontage. Roof form and rooflines shall be designed to avoid the appearance of a large monolithic roof structure as follows: (i) Long pitched or flat roof lines shall avoid continuous expanses without variation by including changes in height and/or roof form, to include

a flat roof and parapet walls. The attached dwellings shall incorporate one of the following into the design of the structure: (i) a variation in the façade depth of adjoining dwelling units of at least one foot (1'). Such variation shall extend the entire height of the façade; and (ii) architectural features, such as balconies, bay windows, or other elements along the façade of each dwelling unit, are subject to the standards of

but not be limited to gables, hips, dormer or parapets; and (ii) For pitched roofs the minimum allowed is 4:12 excluding buildings with

. Meter banks, HVAC, and related mechanical equipment will be screened as required per the Ordinance. Ground-mounted or

wall-mounted mechanical equipment shall not be located in the established setbacks along a frontage. h. Dumpster and recycling area will be fully enclosed on three sides by a minimum 75% opaque fence with one side being a

decorative gate. The fence used to enclose the dumpster will be of a material prescribed by the Ordinance and be of a compatibl color used on the principal buildings. A minimum of 50% of the residential buildings within the multi-dwelling development will contain four (4) or less dwelling units. No more than six (6) attached dwelling units may be located in a residential building. No more than 10% of the total number of

esidential buildings on the Site shall contain six (6) attached dwelling units. All dwelling units will have garages and all residential buildings fronting a network required street will have rear loaded garages. Walkways shall be provided to connect all residential entrances to sidewalks along abutting streets. For dwelling units which

front along a network required street, a direct pedestrian connection will be provided from the entrance to the adjacent public I. Accessory buildings and structures associated with the multi-dwelling development will be constructed utilizing similar building

materials, colors, architectural elements, and designs as the principal building(s) located on the Site.

# 6. <u>Environmental Features</u>:

a. The Petitioner shall comply with the Charlotte City Council approved and adopted Unified Development Ordinance, Stormwater Articles 23 through 28. The location, size, and type of storm water management systems that may be depicted on the Rezoning Plan are subject to review and approval as part of the full development plan submittal and are not implicitly approved with this rezoning. Adjustments may be necessary in order to accommodate actual storm water treatment requirements and natural site discharge

b. The Site will comply with the Tree provisions of the Ordinance found in Article 20. The final location of the required tree save/replanted tree save areas depicted on the Rezoning Plan are subject to review and approval as part of the full development plan submittal and are not implicitly approved with this rezoning petition and are subject to change. . Development within any SWIM/PCSO Buffers shall be coordinated with and subject to approval by Charlotte-Mecklenburg Storm Water Services and mitigated if required by Ordinance. Stream delineation reports are subject to review and approval by

**a.** All freestanding exterior lighting installed on the Site shall comply with Article 16.2 of the Ordinance.

# 8. Amendments to the Rezoning Plan:

Charlotte Storm Water Services.

a. Future amendments to the Rezoning Plan (which includes these Development Standards) may be applied for by the then Owner or Owners of the applicable development area or portion of the Site affected by such amendment in accordance with the provisions herein and of Article 37.3 of the Ordinance.

# Binding Effect of the Rezoning Application:

a. If this Rezoning Petition is approved, all conditions applicable to the development of the Site imposed under the Rezoning Plan will, unless amended in the manner provided under the Ordinance, be binding upon and inure to the benefit of the Petitioner and subsequent owners of the Site and their respective heirs, devisees, personal representatives, successors in interest or assigns.

This Plan Is A

Preliminary Design NOT Released For Construction. PROPERTY BOUNDARY **EXISTING CONTOUR LINES** EXISTING LOT LINE 400 **RIGHT-OF-WAY LINE** SETBACK LINE SCALE: 1" = 100' EXISTING PAVEMENT **REVISIONS:** PROPOSED CURBING No. Date By Description EXISTING CURBING |07/15/25 | ENLS | PER REVIEWER COMMENTS 2 | 08/21/25 | LJP | REVISIONS PER STAFF COMMENTS ROAD CENTERLINE

**CORPORATE CERTIFICATIONS** NC PE : C-2930 NC LA : C-253 SC ENG: NO. 3599 SC LA: NO. 211

Drawn By:

Project Manager

Checked By:

7/15/2025

**REZONING** 

**TECHNICAL** 


**DATA SHEET** 

PETITION NO. RZP-2025-048

Project Number:

Sheet Number:

SHEET # 01 OF 02

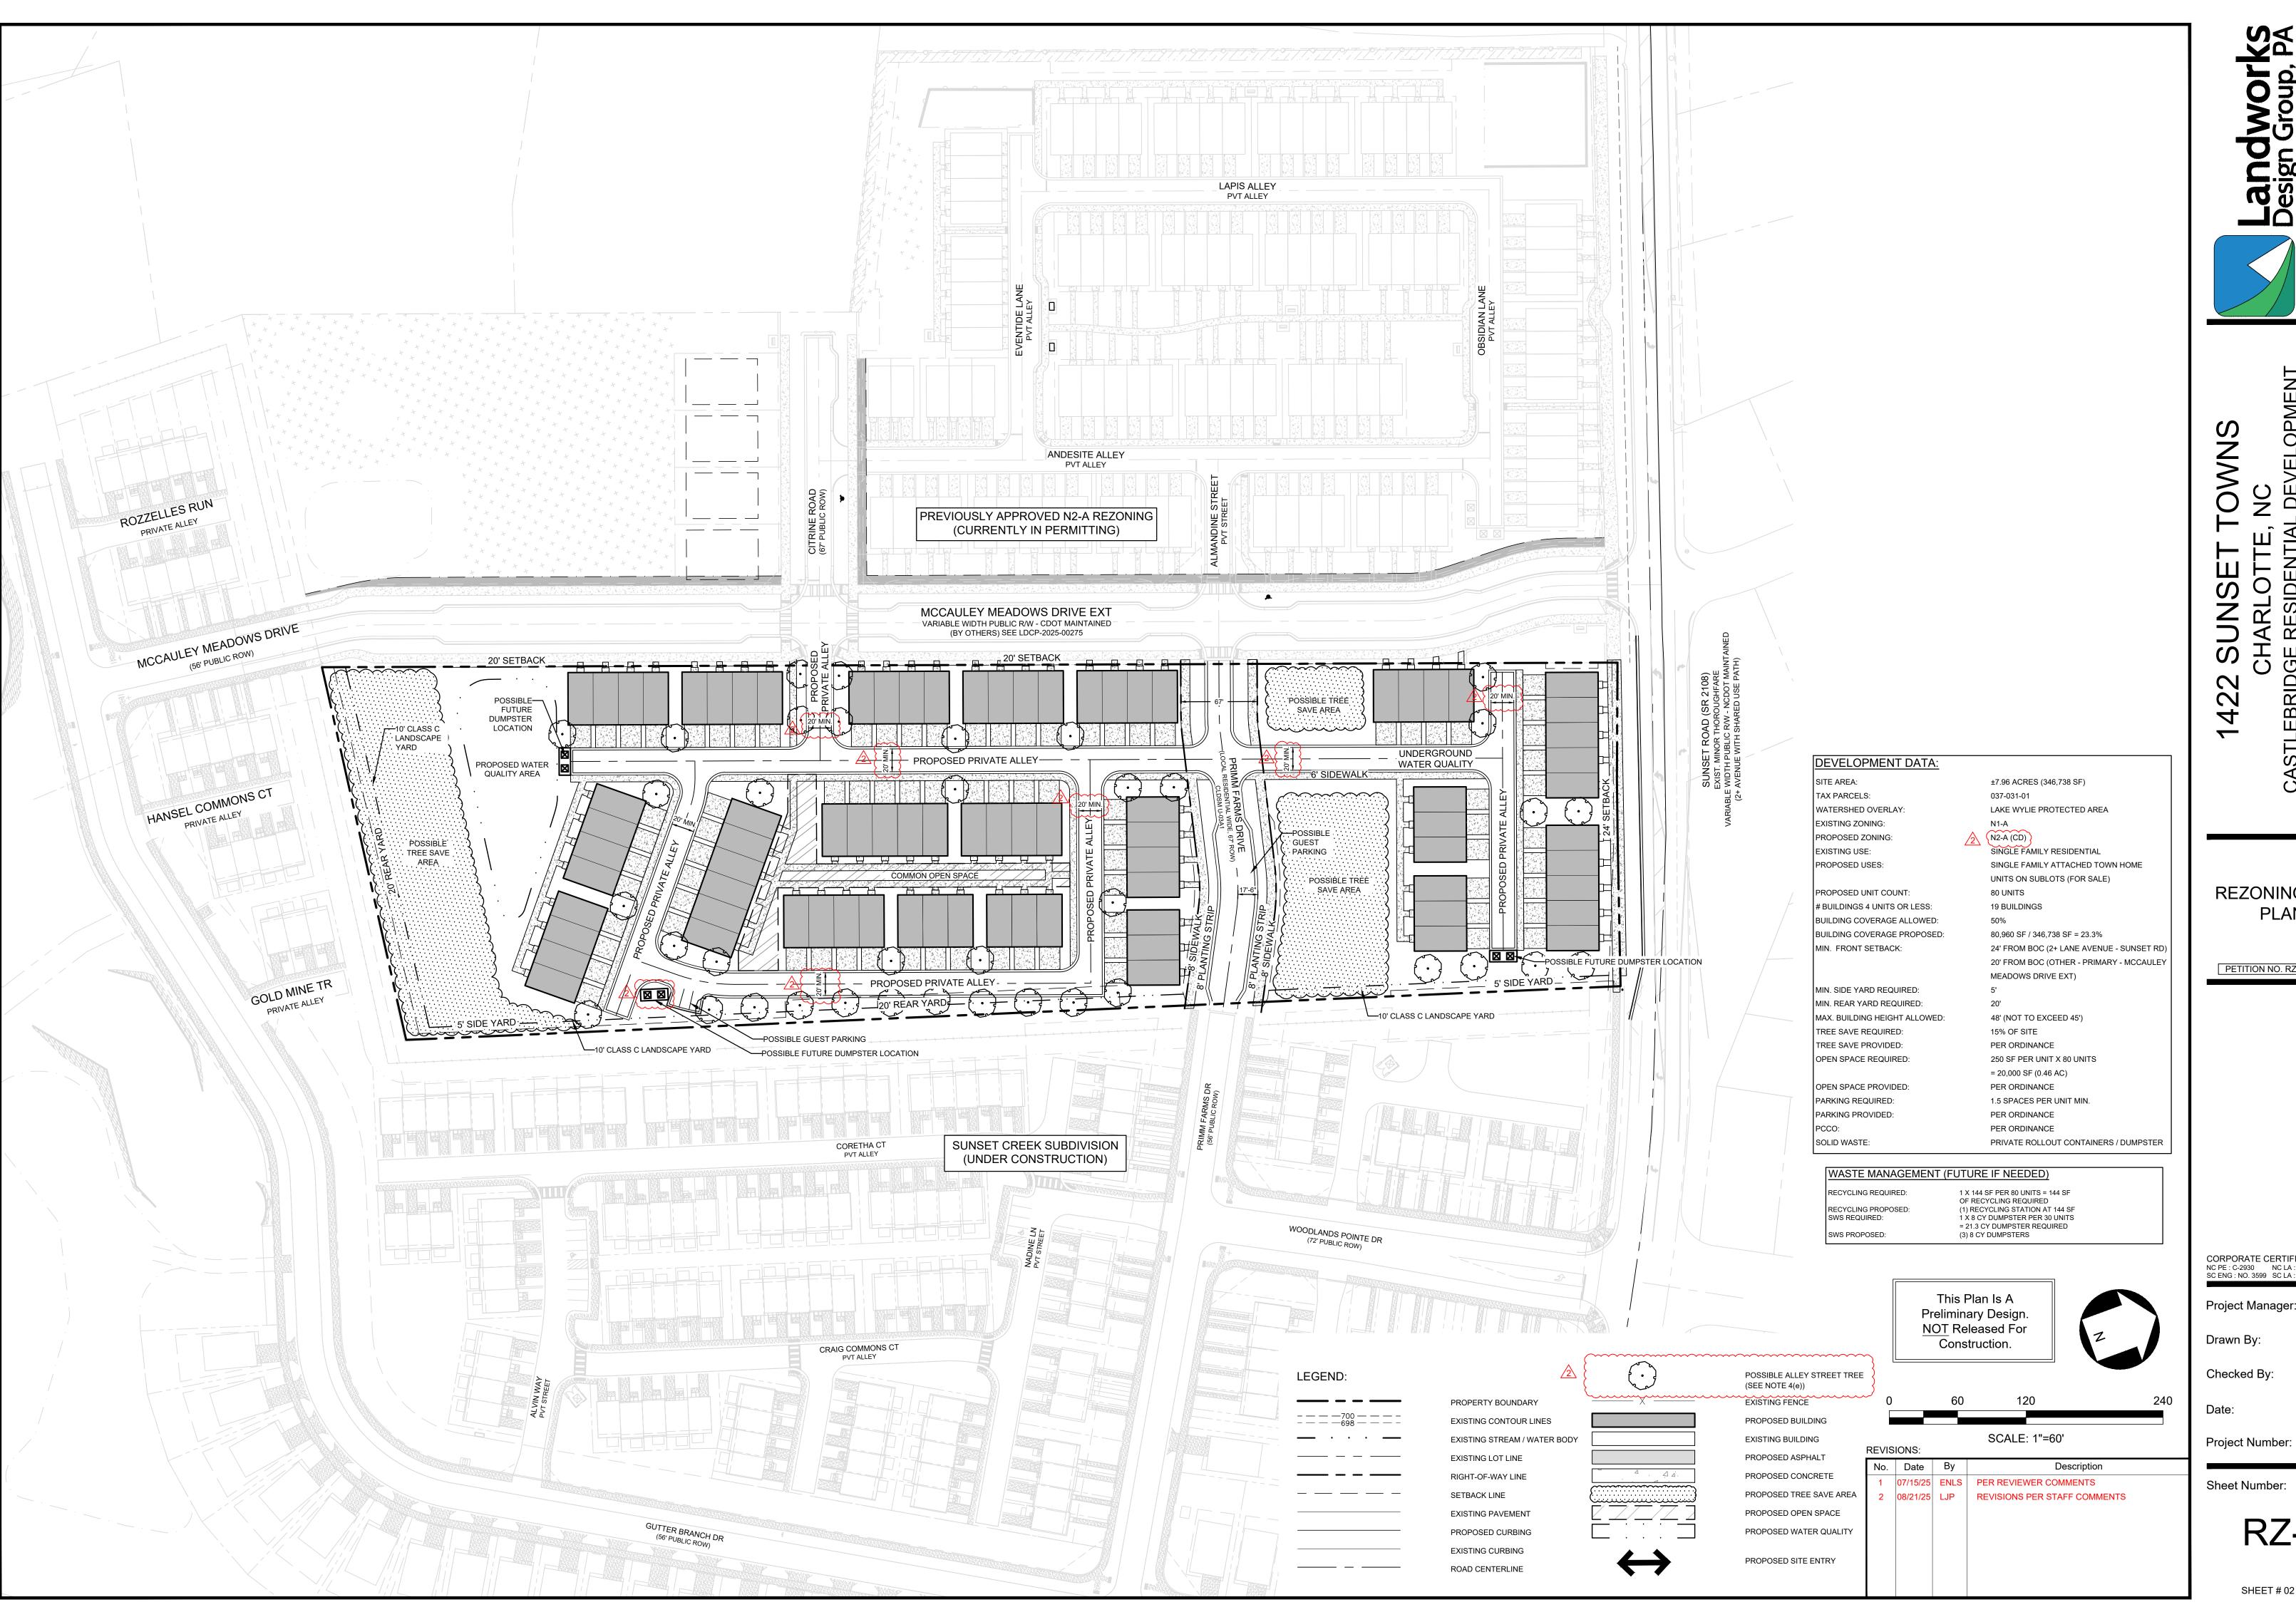

**REZONING SITE** PLAN

PETITION NO. RZP-2025-048

CORPORATE CERTIFICATIONS

NC PE : C-2930 NC LA : C-253

SC ENG : NO. 3599 SC LA : NO. 211

Project Manager:

**ENLS** Drawn By:

7/15/2025

Sheet Number:

RZ-2

SHEET # 02 OF 02