

TO REMAIN (TYP.)

SIDEWALK

PROPOSED MUP SIDEWALK


PID: 101-21-213

RANDY E STONE JOANNA DOUGHERTY-STONE

USE: SINGLE FAMILY RESIDENTIAL

ZONING: R-4

TO TIE INTO EXISTING -

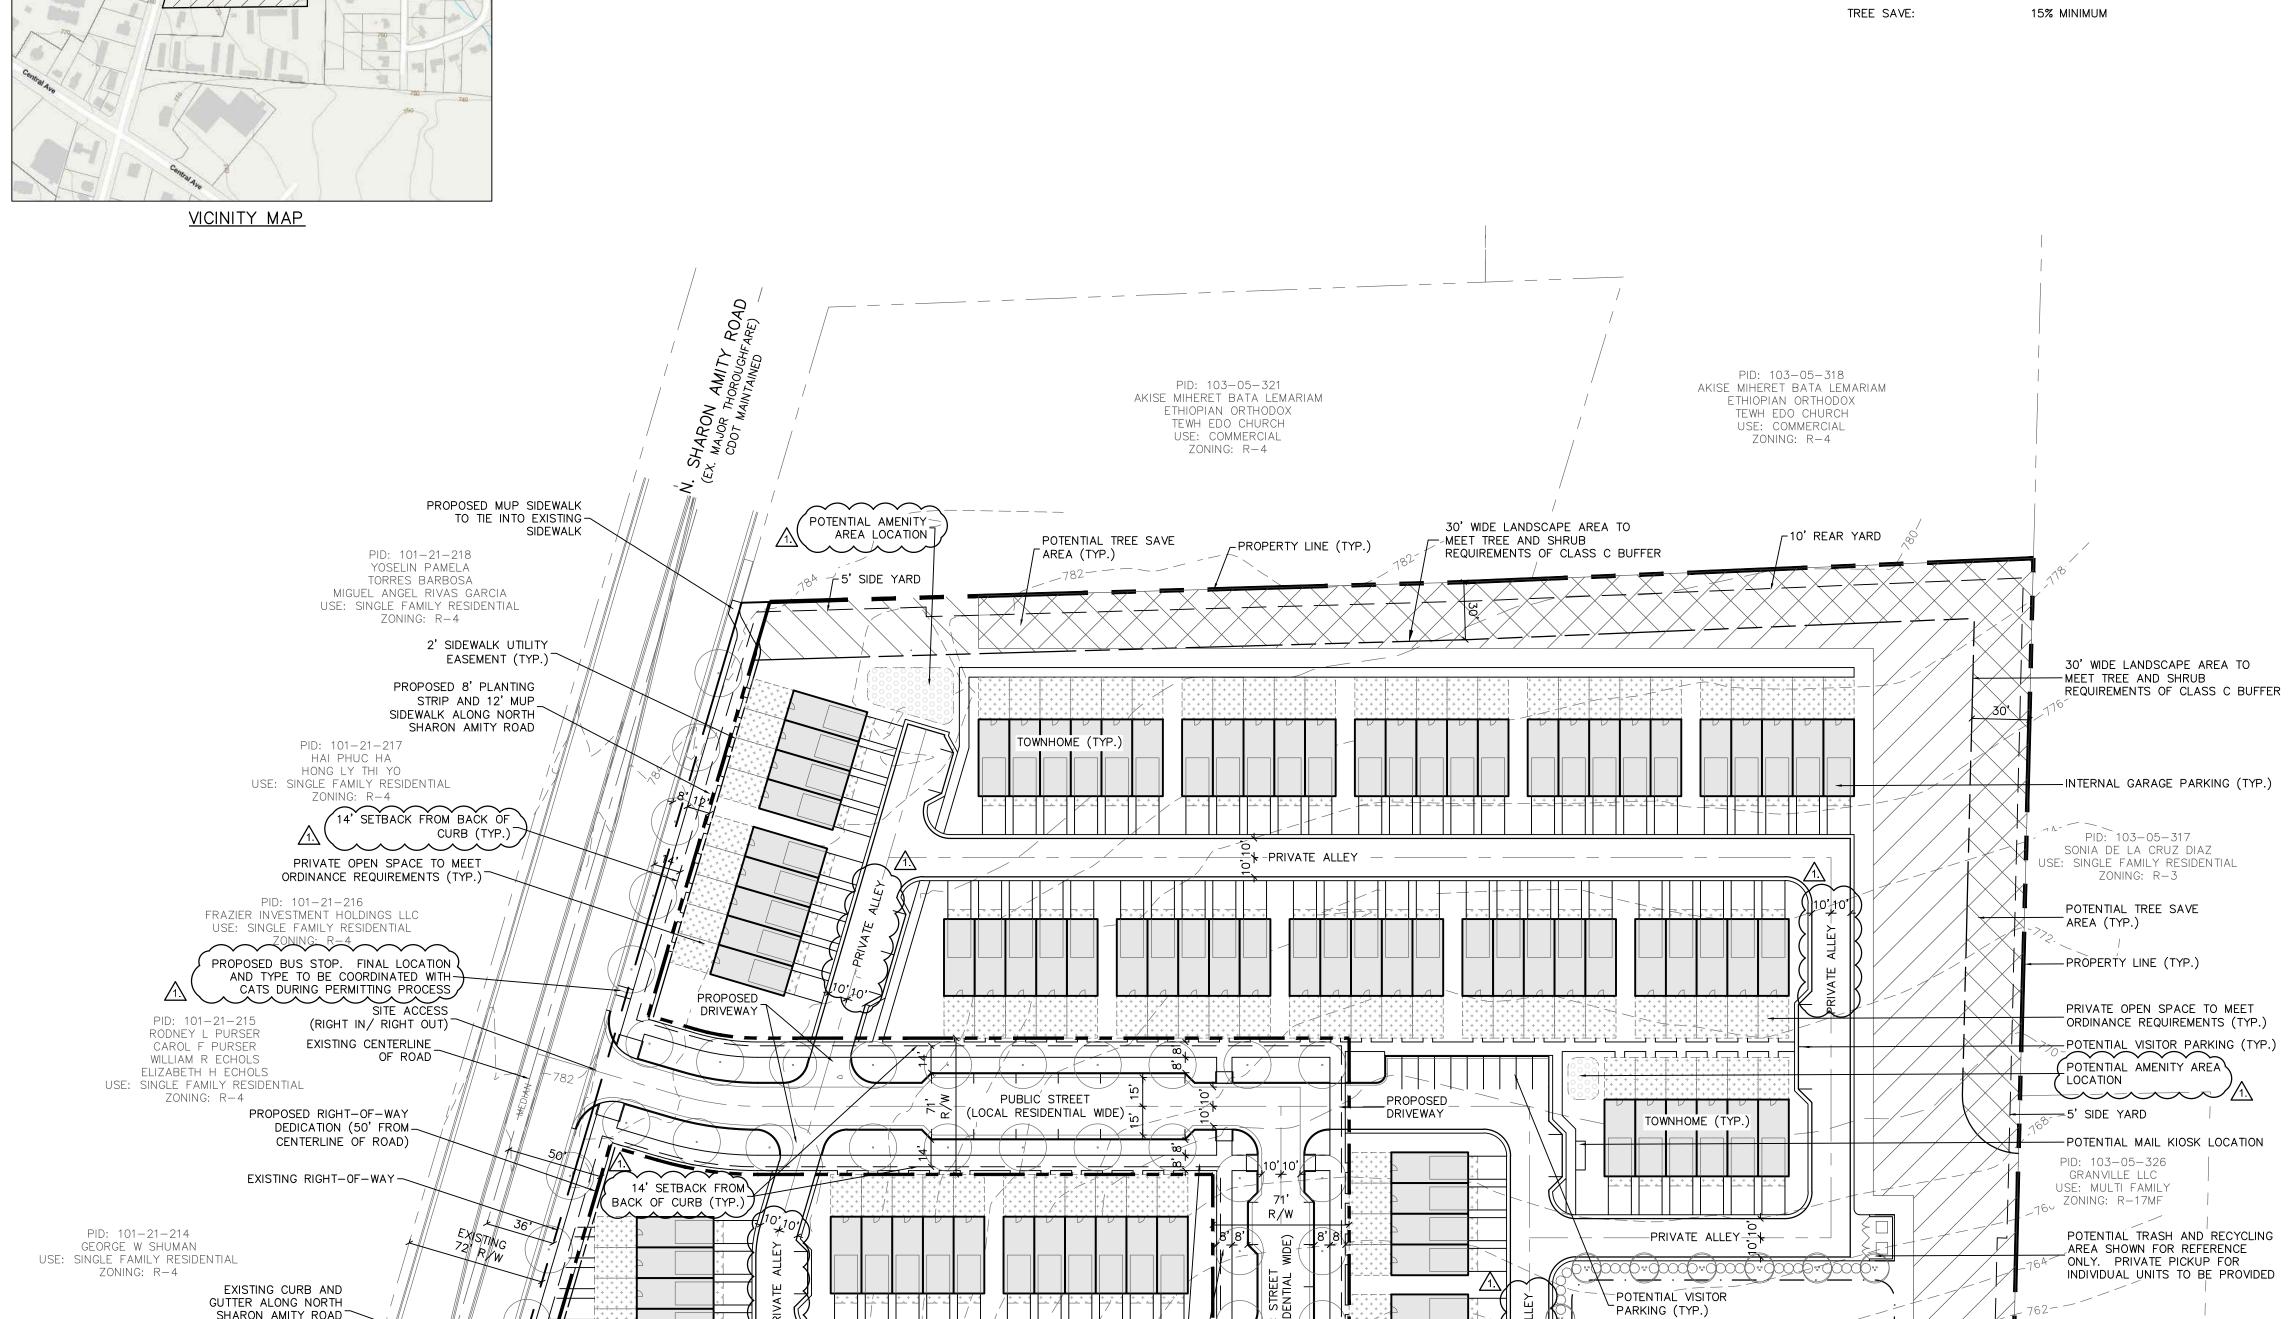

-PRIVATE ALLEY-

L10' REAR YARD

 $\,\,\,\,$ PROPERTY LINE (TYP.)

POTENTIAL TREE SAVE

AREA (TYP.)

PID: 103-05-325

SERGIO E VELASQUEZ

AURELIO J NAVARRO MIRANDA USE: SINGLE FAMILY RESIDENTIAL

ZONING: R-4

└5' SIDE YARD

MEET TREE AND SHRUB -

30' WIDE LANDSCAPE AREA TO

REQUIREMENTS OF CLASS C BUFFER

PLANTING STRIP AND

8 'SIDEWALK ALONG

NEW PUBLIC STREETS

PROPOSED 8'-

PROPOSED

DRIVEWAY

<u>DEVELOPMENT STANDARDS</u>

SITE DATA

±7.49 ACRES

R-4

UR-2(CD)

SINGLE FAMILY

90 TOWNHOMES

10305322, 10305323, 1030524

±12.02 UNITS PER ACRE

PER ORDINANCE REQUIREMENTS

——10' REAR YARD

└10' REAR YARD

POTENTIAL

DETENTION

LOCATION

ENHANCED PLANTING TO

LBE PROVIDED TO SCREEN

DETENTION LOCATION

INTERNAL GARAGE

PARKING (TYP.)

L5' SIDE YARD

PID: 103-05-326

GRANVILLE LLC

USE: MULTI FAMILY

ZONING: R-17MF

PROPOSED ON-STREET

PARKING (TYP.)

PER ORDINANCE REQUIREMENTS

SINGLE FAMILY ATTACHED TOWNHOMES

SITE AREA:

TAX MAP NO:

EXISTING USE:

PROPOSED USE:

PROPOSED UNITS:

BUILDING HEIGHT:

PARKING PROVIDED:

PROPOSED DENSITY:

EXISTING ZONING:

PROPOSED ZONING:

A. GENERAL PROVISIONS

1. THESE DEVELOPMENT STANDARDS FORM A PART OF THE REZONING PLAN ASSOCIATED WITH THE REZONING PETITION FILED BY FIORENZA PROPERTIES, LLC (THE "PETITIONER") TO ACCOMMODATE THE DEVELOPMENT OF A RESIDENTIAL COMMUNITY ON THAT APPROXIMATELY 7.49 ACRE SITE LOCATED ON THE EAST SIDE OF NORTH SHARON AMITY ROAD BETWEEN CENTRAL AVENUE AND WILORA LAKE ROAD, WHICH SITE IS MORE PARTICULARLY DEPICTED ON THE REZONING PLAN (THE "SITE"). THE SITE IS COMPRISED OF TAX PARCEL NOS. 103-053-22,

2. THE DEVELOPMENT AND USE OF THE SITE WILL BE GOVERNED BY THE REZONING PLAN, THESE DEVELOPMENT STANDARDS AND THE APPLICABLE PROVISIONS OF THE CITY OF CHARLOTTE ZONING ORDINANCE (THE "ORDINANCE")

3. UNLESS THE REZONING PLAN OR THESE DEVELOPMENT STANDARDS ESTABLISH MORE STRINGENT STANDARDS, THE REGULATIONS ESTABLISHED UNDER THE ORDINANCE FOR THE UR-2 ZONING DISTRICT SHALL GOVERN THE DEVELOPMENT AND USE OF THE SITE.

4. THE DEVELOPMENT DEPICTED ON THE REZONING PLAN IS SCHEMATIC IN NATURE AND INTENDED TO DEPICT THE GENERAL ARRANGEMENT OF USES AND IMPROVEMENTS ON THE SITE. ACCORDINGLY, THE CONFIGURATIONS, PLACEMENTS AND SIZES OF THE BUILDING FOOTPRINTS AS WELL AS THE INTERNAL PUBLIC STREETS AND THE INTERNAL PRIVATE STREETS/ALLEYS DEPICTED ON THE REZONING PLAN ARE SCHEMATIC IN NATURE AND, SUBJECT TO THE TERMS OF THESE DEVELOPMENT STANDARDS AND THE ORDINANCE, ARE SUBJECT TO MINOR ALTERATIONS OR MODIFICATIONS DURING THE DESIGN DEVELOPMENT AND CONSTRUCTION DOCUMENT PHASES.

5. FUTURE AMENDMENTS TO THE REZONING PLAN AND/OR THESE DEVELOPMENT STANDARDS MAY BE APPLIED FOR BY THE THEN OWNER OR OWNERS OF THE SITE IN ACCORDANCE WITH THE PROVISIONS OF CHAPTER 6 OF THE ORDINANCE. ALTERATIONS TO THE REZONING PLAN ARE SUBJECT TO SECTION 6.207 OF THE ORDINANCE.

B. <u>PERMITTED USES/DEVELOPMENT LIMITATIONS</u>
1. THE SITE MAY BE DEVOTED ONLY TO A RESIDENTIAL COMMUNITY CONTAINING A MAXIMUM OF 90 SINGLE FAMILY ATTACHED DWELLING UNITS AND TO ANY INCIDENTAL AND ACCESSORY USES RELATING THERETO THAT ARE ALLOWED IN THE UR-2 ZONING DISTRICT.

C. TRANSPORTATION

1. VEHICULAR ACCESS TO THE SITE SHALL BE AS CENERALLY DEPICTED ON THE REZONING PLAN. THE PLACEMENT AND CONFIGURATION OF THE VEHICULAR ACCESS POINT ARE SUBJECT TO ANY MINOR MODIFICATIONS REQUIRED TO ACCOMMODATE FINAL SITE AND CONSTRUCTION PLANS AND DESIGNS AND TO ANY ADJUSTMENTS REQUIRED FOR APPROVAL BY THE CHARLOTTE DEPARTMENT OF TRANSPORTATION.

2. AS DEPICTED ON THE REZONING PLAN, THE SITE WILL BE SERVED BY INTERNAL PUBLIC STREETS AND INTERNAL PUBLIC STREETS AND PRIVATE STREETS AND MINOR ADJUSTMENTS TO THE LOCATIONS OF THE INTERNAL PUBLIC STREETS AND

2. AS DĚPICŤED ON ŤHE ŘEZŎNINĞ PLĂN, ŤHE SITE WILL BE SEŘVEĎ BY INTĚRNÁL PŮBLIČ SŤŘEEŤS AŇD INTEŘNAL
PRIVATE STREETS/ALLEYS, AND MINOR ADJUSTMENTS TO THE LOCATIONS OF THE INTERNAL PUBLIC STREETS AND
THE INTERNAL PRIVATE STREETS/ALLEYS SHALL BE ALLOWED DURING THE CONSTRUCTION PERMITTING PROCESS.

3. INTERNAL SIDEWALKS AND PEDESTRIAN CONNECTIONS SHALL BE PROVIDED ON THE SITE AS GENERALLY DEPICTED
ON THE REZONING PLAN. THE INTERNAL SIDEWALKS MAY MEANDER TO SAVE EXISTING TREES.

4. PRIOR TO THE ISSUANCE OF THE FIRST CERTIFICATE OF OCCUPANCY FOR A NEW SINGLE FAMILY ATTACHED

4. PRIOR TO THE ISSUANCE OF THE FIRST CERTIFICATE OF OCCUPANCY FOR A NEW SINGLE FAMILY ATTACHED DWELLING UNIT CONSTRUCTED ON THE SITE, PETITIONER SHALL DEDICATE AND CONVEY TO THE CITY OF CHARLOTTE (SUBJECT TO A RESERVATION FOR ANY NECESSARY UTILITY EASEMENTS) THOSE PORTIONS OF THE SITE LOCATED IMMEDIATELY ADJACENT TO NORTH SHARON AMITY ROAD AS REQUIRED TO PROVIDE RIGHT OF WAY MEASURING 50 FEET FROM THE CENTERLINE OF EXISTING NORTH SHARON AMITY ROAD, TO THE EXTENT THAT SUCH RIGHT OF WAY DOES NOT ALREADY EXIST.

5. ALL TRANSPORTATION IMPROVEMENTS SET OUT IN THIS SECTION C OF THE DEVELOPMENT STANDARDS SHALL BE CONSTRUCTED AND APPROVED PRIOR TO THE ISSUANCE OF THE FIRST CERTIFICATE OF OCCUPANCY FOR A NEW SINGLE FAMILY ATTACHED DWELLING UNIT CONSTRUCTED ON THE SITE.

6. PETITIONER WILL DEDICATE VIA FEE SIMPLE CONVEYANCE ANY ADDITIONAL RIGHT-OF-WAY INDICATED ON THE REZONING PLAN AS RIGHT-OF-WAY TO BE DEDICATED, AND THE ADDITIONAL RIGHT-OF-WAY WILL BE DEDICATED PRIOR TO THE ISSUANCE OF THE FIRST CERTIFICATE OF OCCUPANCY FOR A NEW SINGLE FAMILY ATTACHED DWELLING UNIT CONSTRUCTED ON THE SITE. PETITIONER WILL PROVIDE A PERMANENT SIDEWALK EASEMENT FOR ANY OF THE PROPOSED SIDEWALKS LOCATED ALONG THE PUBLIC STREETS LOCATED OUTSIDE OF THE RIGHT-OF-WAY. THE PERMANENT SIDEWALK EASEMENT WILL BE LOCATED A MINIMUM OF TWO (2) FEET BEHIND THE SIDEWALK WHERE FEASIBLE.

7. A MINIMUM OF 10 VISITOR PARKING SPACES SHALL BE PROVIDED ON THE SITE.

SUBJECT TO THE APPROVAL OF CDOT AND ANY OTHER GOVERNMENTAL AGENCIES, PETITIONER SHALL, PRIOR TO THE ISSUANCE OF THE FIRST CERTIFICATE OF OCCUPANCY FOR A NEW SINGLE FAMILY ATTACHED DWELLING UNIT CONSTRUCTED ON THE SITE, CONSTRUCT AN ADA COMPLIANT BUS AMENITY ON THE SITE'S FRONTAGE ON NORTH SHARON AMITY ROAD. THE FINAL LOCATION AND TYPE OF AMENITY WILL BE COORDINATED WITH CATS DURING THE PERMITTING PROCESS. IN THE EVENT THAT PETITIONER CANNOT OBTAIN ALL APPROVALS AND PERMITS REQUIRED TO CONSTRUCT THE BUS AMENITY, THEN PETITIONER SHALL HAVE NO OBLIGATION TO CONSTRUCT THE BUS AMENITY.

ARCHITECTURAL STANDARDS

THE FRONT ELEVATIONS OF THE SINGLE FAMILY ATTACHED DWELLING UNITS ADJACENT TO NORTH SHARON AMITY ROAD.

THE PRIMARY EXTERIOR BUILDING MATERIALS FOR THE SINGLE FAMILY ATTACHED DWELLING UNITS TO BE

 THE PRIMARY EXTERIOR BUILDING MATERIALS FOR THE SINGLE FAMILY ATTACHED DWELLING UNITS TO BE CONSTRUCTED ON THE SITE WILL BE ONE OR MORE OF THE FOLLOWING: BRICK VENEER OR SIMILAR MASONRY PRODUCTS, STONE, MANUFACTURED STONE, STUCCO AND CEMENTITIOUS SIDING.

3. VINYL, EIFS OR MASONITE MAY NOT BE USED AS AN EXTERIOR BUILDING MATERIAL ON ANY BUILDING TO BE CONSTRUCTED ON THE SITE. NOTWITHSTANDING THE FOREGOING, VINYL MAY BE UTILIZED ON WINDOWS, DOORS, GARAGE DOORS, SOFFITS, TRIM AND RAILINGS.

4. THE ACTUAL WIDTHS OF THE SINGLE FAMILY ATTACHED DWELLING UNITS CONSTRUCTED ON THE SITE MAY VARY FROM THE WIDTHS DEPICTED ON THE REZONING PLAN.

5. TO PROVIDE PRIVACY, ALL RESIDENTIAL ENTRANCES WITHIN 15 FEET OF THE SIDEWALK MUST BE RAISED FROM GRADE A MINIMUM OF 12 TO 24 INCHES.

PITCHED ROOFS, IF PROVIDED, SHALL BE SYMMETRICALLY SLOPED NO LESS THAN 5:12, EXCEPT THAT ROOFS FOR PORCHES AND ATTACHED SHEDS MAY BE NO LESS THAN 2:12, UNLESS A FLAT ROOF ARCHITECTURAL STYLE IS EMPLOYED.

. ALL CORNER/END UNITS THAT FACE A PUBLIC OR PRIVATE STREET SHALL HAVE A PORCH OR STOOP THAT WRAPS A PORTION OF THE FRONT AND SIDE OF THE UNIT OR PROVIDE BLANK WALL PROVISIONS THAT LIMIT THE MAXIMUM BLANK WALL EXPANSE TO 10 FEET ON ALL BUILDING LEVELS.

8. EACH SINGLE FAMILY ATTACHED DWELLING UNIT SHALL HAVE A TWO CAR GARAGE. THE TWO CAR GARAGES MAY
BE TANDEM TWO CAR GARAGES.

THE SINGLE FAMILY ATTACHED DWELLING UNITS SHALL BE REAR LOADED UNITS.

10.) WALKWAYS SHALL BE PROVIDED TO CONNECT ALL RESIDENTIAL ENTRANCES TO SIDEWALKS ALONG PUBLIC STREETS OR PRIVATE STREETS/ALLEYS

11. IF A FENCE IS INSTALLED IN THE FRONT YARD OF ANY SINGLE FAMILY ATTACHED DWELLING UNIT, THE FENCE SHALL HAVE A MAXIMUM HEIGHT OF 48 INCHES, AND THE FENCE MUST BE A DECORATIVE, BLACK, NON-OPAQUE FENCE.

E. STREETSCAPE AND LANDSCAPING

1. A MINIMUM 8 FOOT WIDE PLANTING STRIP AND A MINIMUM 12 FOOT WIDE MULTI-USE PATH SHALL BE INSTALLED ALONG THE SITE'S FRONTAGE ON NORTH SHARON AMITY ROAD AS GENERALLY DEPICTED ON THE REZONING PLAN. THE MULTI-USE PATH, OR PORTIONS THEREOF, MAY BE LOCATED IN A SIDEWALK LITILITY EASEMENT.

2. A MINIMUM 8 FOOT WIDE PLANTING STRIP AND A MINIMUM 8 FOOT WIDE SIDEWALK SHALL BE INSTALLED ON BOTH SIDES OF THE INTERNAL PUBLIC STREETS ON THE SITE.

3. A MINIMUM 30 FOOT WIDE LANDSCAPE AREA SHALL BE ESTABLISHED ALONG THOSE PORTIONS OF THE SITE'S BOUNDARY LINES THAT ARE MORE PARTICULARLY DEPICTED ON THE REZONING PLAN. AT A MINIMUM, THIS 30 FOOT WIDE LANDSCAPE AREA SHALL MEET THE TREE AND SHRUB REQUIREMENTS OF A CLASS C BUFFER. IF THE EXISTING TREES AND SHRUBS LOCATED WITHIN THIS 30 FOOT WIDE LANDSCAPE AREA DO NOT MEET THE TREE

FOOT WIDE LANDSCAPE AREA SHALL MEET THE TREE AND SHRUB REQUIREMENTS OF A CLASS C BUFFER. IF THE EXISTING TREES AND SHRUBS LOCATED WITHIN THIS 30 FOOT WIDE LANDSCAPE AREA DO NOT MEET THE TREE AND SHRUB REQUIREMENTS OF A CLASS C BUFFER, THEN PETITIONER SHALL PLANT AND INSTALL SUPPLEMENTAL TREES AND SHRUBS TO BRING THE 30 FOOT WIDE LANDSCAPE AREA INTO COMPLIANCE WITH THE TREE AND SHRUB REQUIREMENTS OF A CLASS C BUFFER.

F. ENVIRONMENTAL

1. DEVELOPMENT OF THE SITE SHALL COMPLY WITH THE CITY OF CHARLOTTE TREE ORDINANCE.

2. PETITIONER SHALL COMPLY WITH THE CHARLOTTE CITY COUNCIL APPROVED AND ADOPTED POST CONSTRUCTION STORMWATER ORDINANCE.

3. THE LOCATION, SIZE AND TYPE OF STORM WATER MANAGEMENT SYSTEMS DEPICTED ON THE REZONING PLAN ARE SUBJECT TO REVIEW AND APPROVAL AS PART OF THE FULL DEVELOPMENT PLAN SUBMITTAL AND ARE NOT IMPLICITLY APPROVED WITH THIS REZONING. ADJUSTMENTS MAY BE NECESSARY IN ORDER TO ACCOMMODATE ACTUAL STORM WATER TREATMENT REQUIREMENTS AND NATURAL SITE DISCHARGE POINTS.

G. <u>LIGHTING</u>

1. ALL FREESTANDING LIGHTING FIXTURES INSTALLED ON THE SITE (EXCLUDING STREET LIGHTS AND LOWER, DECORATIVE LIGHTING THAT MAY BE INSTALLED ALONG THE DRIVEWAYS AND SIDEWALKS AND LANDSCAPING LIGHTING) SHALL BE FULLY CAPPED AND SHIELDED AND THE ILLUMINATION DOWNWARDLY DIRECTED SO THAT

DIRECT ILLUMINATION DOES NOT EXTEND PAST ANY PROPERTY LINE OF THE SITE.

2. THE MAXIMUM HEIGHT OF ANY PEDESTRIAN SCALE, FREESTANDING LIGHTING FIXTURE INSTALLED ON THE SITE, INCLUDING ITS BASE, SHALL NOT EXCEED 21 FEET.

TWO AMENITY/OPEN SPACE AREAS SHALL BE PROVIDED ON THE SITE, AND THE TOTAL COMBINED MINIMUM SIZE OF THESE AMENITY/OPEN SPACE AREAS SHALL BE 1,200 SQUARE FEET. THESE AMENITY/OPEN SPACE AREAS SHALL, AT A MINIMUM, CONTAIN GRASS, SHRUBS, PEDESTRIAN WALKWAYS AND SEATING.

BINDING EFFECT OF THE REZONING DOCUMENTS AND DEFINITIONS

1. IF THIS REZONING PETITION IS APPROVED, ALL CONDITIONS APPLICABLE TO THE USE AND DEVELOPMENT OF THE SITE IMPOSED UNDER THESE DEVELOPMENT STANDARDS AND THE REZONING PLAN WILL, UNLESS AMENDED IN THE MANNER PROVIDED UNDER THE ORDINANCE, BE BINDING UPON AND INURE TO THE BENEFIT OF PETITIONER AND THE CURRENT AND SUBSEQUENT OWNERS OF THE SITE AND THEIR RESPECTIVE SUCCESSORS IN INTEREST AND

2. THROUGHOUT THESE DEVELOPMENT STANDARDS, THE TERM "PETITIONER" SHALL BE DEEMED TO INCLUDE THE HEIRS, DEVISEES, PERSONAL REPRESENTATIVES, SUCCESSORS IN INTEREST AND ASSIGNS OF PETITIONER OR THE OWNER OR OWNERS OF THE SITE FROM TIME TO TIME WHO MAY BE INVOLVED IN ANY FUTURE DEVELOPMENT


3. ANY REFERENCE TO THE ORDINANCE HEREIN SHALL BE DEEMED TO REFER TO THE REQUIREMENTS OF THE ORDINANCE IN EFFECT AS OF THE DATE THIS REZONING PETITION IS APPROVED.

Copyright © 2022 Design Resource Group, PA This plan or drawing and any accompanying documents or calculations are the property of Design Resource Group, PA, and are intended solely for the use of the recipient noted. No third party use or modification is permitted without written authorization

CITAL DESIGNATES OURCE GROUP

LANDSCAPE ARCHITECTURE CIVIL ENGINEERING TRANSPORTATION PLANNING

2459 Wilkinson Blvd, Ste 200 Charlotte, NC 28208 704.343.0608 www.drgrp.com

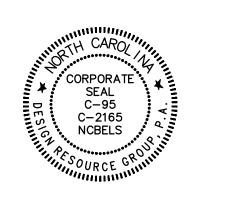

REZONING PETITION FOR PUBLIC HEARING 2022-015

REZONING DOCUMENT

MES

JyFiorenza Communities

KINGSTON AVE., SUITE 16


CHARLOTTE, NC 28203
704.905.9908

0 9

ARC CHARL

b) 118 E.

SCHEMATIC SITE PLAN

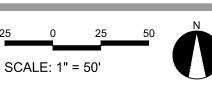

PROJECT #: 843-017
DRAWN BY: BG
CHECKED BY: BG

107/11/22 PER STAFF REVIEW COMMENTS

JANUARY 31, 2022

REVISIONS: