

223-451-81 MECKLENBURG COUNTY (3.78) 3.62 AC NET OF EXISTING R/W 42 STALLS (NS DISTRICT) A MINIMUM OF 1.5 PARKING SPACES PER DWELLING UNIT AND A MINIMUM OF 1.0 PARKING SPACE FOR EACH 300 350 GROSS SQUARE FEET OF OFFICE USE WILL BE PROVIDED.

R8-MF (CD)

SINGLE FAMILY DWELLING UNIT (STRUCTURE) & VACANT LAND NS (NEIGHBORHOOD SERVICES) UP TO 24 MULTI-FAMILY RESIDENTIAL DWELLING UNITS AND UP TO 10,000 SQ.FT. OF GROSS FLOOR AREA OF GENERAL AND MEDICAL OFFICE USE TOGETHER WITH ACCESSORY USES, AS ALLOWED IN THE NS ZONING DISTRICT.

25'	**
10'	
20'	

*NOT TO EXCEED (3) STORIES OR 40 FEET FOR MULTI-FAMILY RESIDENTIAL BUILDING; AND NOT TO EXCEED ONE (1) STORY AND 30 FEET FOR THE PROPOSED OFFICE BUILDINGS, BUILDING HEIGHT TO

** 25' FROM BACK OF EXISTING OR PROPOSED CURB, WHICHEVER IS

EXISTING TREES TO BE SAVED

PROPOSED STREET TREES

PROPOSED WATER QUALITY

PROPOSED RAIN GARDEN

PROPOSED BLDG ENVELOPE




CITY OF CHARLOTTE REZONING 2014-001(C) LANCASTER HWY CONCEPTUAL SITE PLAN SOUTHERN APARTMENT GROUP: MECKLENBURG COUNTY

REVISION 09/12/14

REZONING COM

985 RZ-2

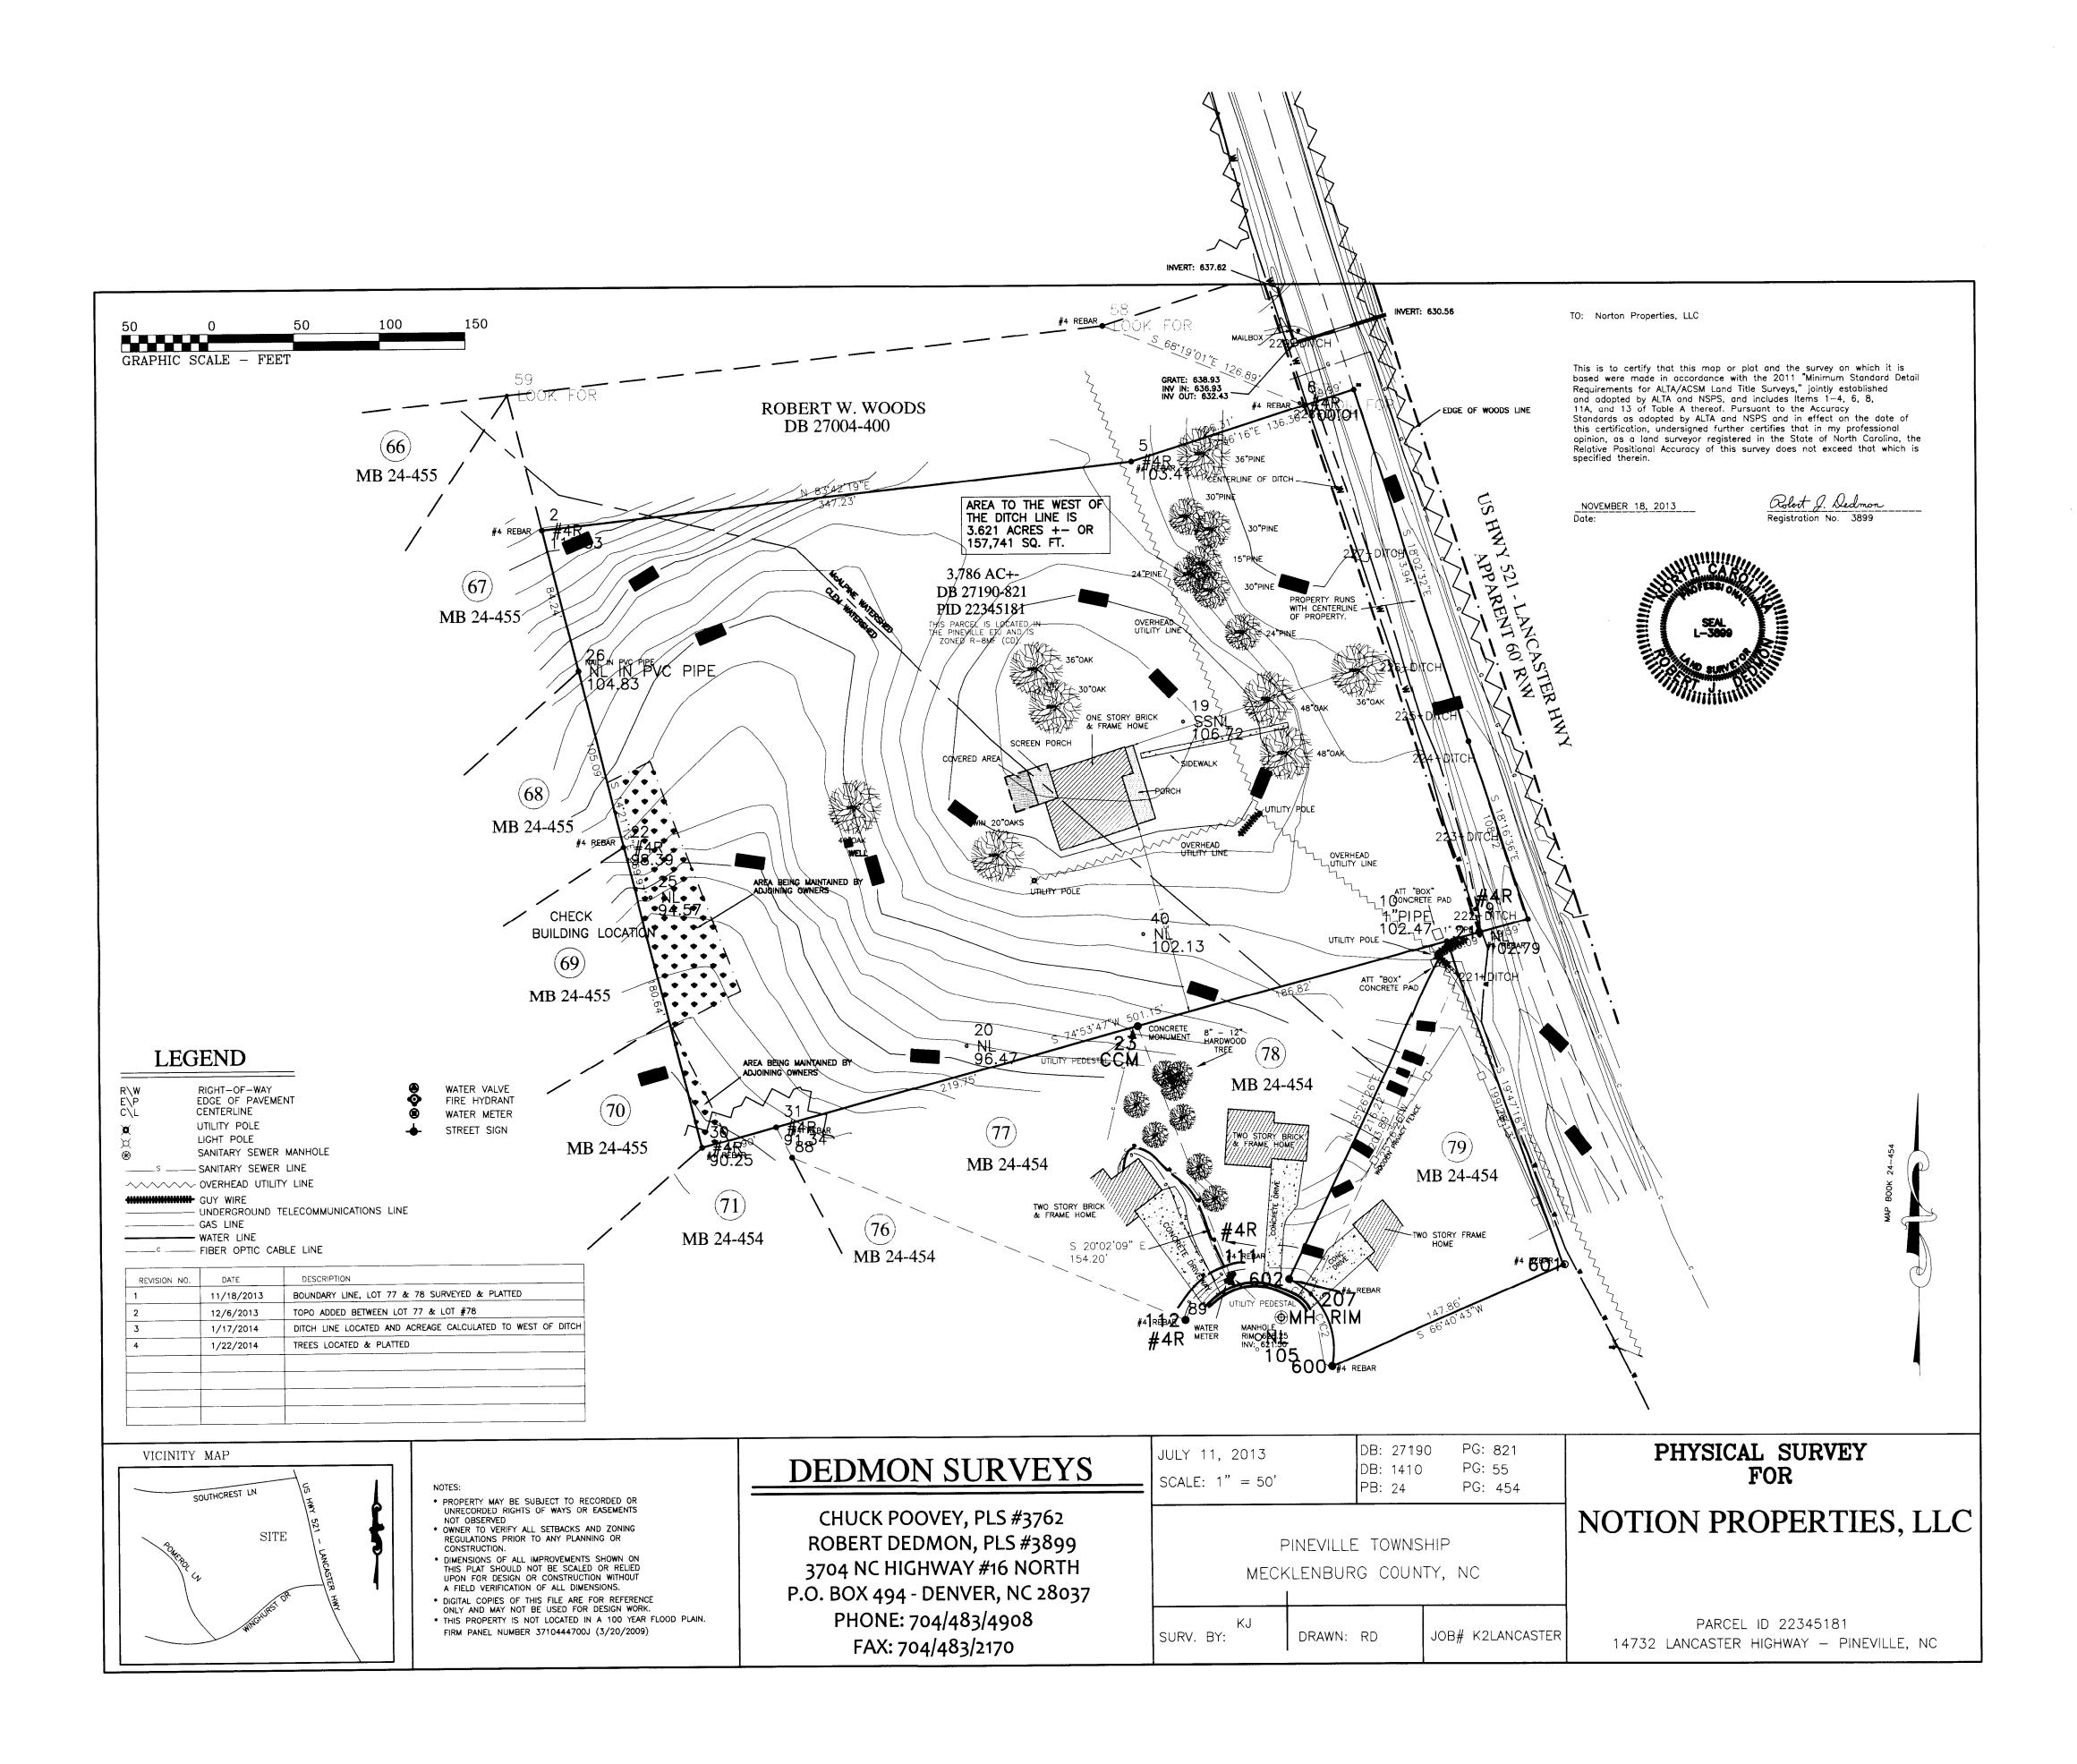

.

DEVELOPMENT DATA

TAX PARCEL ID [#]'S: ZONING JURISDICTION: TOTAL SITE ACREAGE:

Zoning:

EXISTING ZONING: EXISTING USE:

223-451-81 MECKLENBURG COUNTY (3.78) 3.62 AC NET OF EXISTING R/W

R8-MF(CD)SINGLE FAMILY DWELLING UNIT (structure) & vacant land

DEC : 8 2014

APPROVED BY BOARD OF COUNTY COMMISSIONERS FEB - 3 2015



- ----



1EET 0132:

N

K

PETITION #: 2014-001(C) CITY OF CHARLOTTE

25'


0'

25'


50'

÷

r

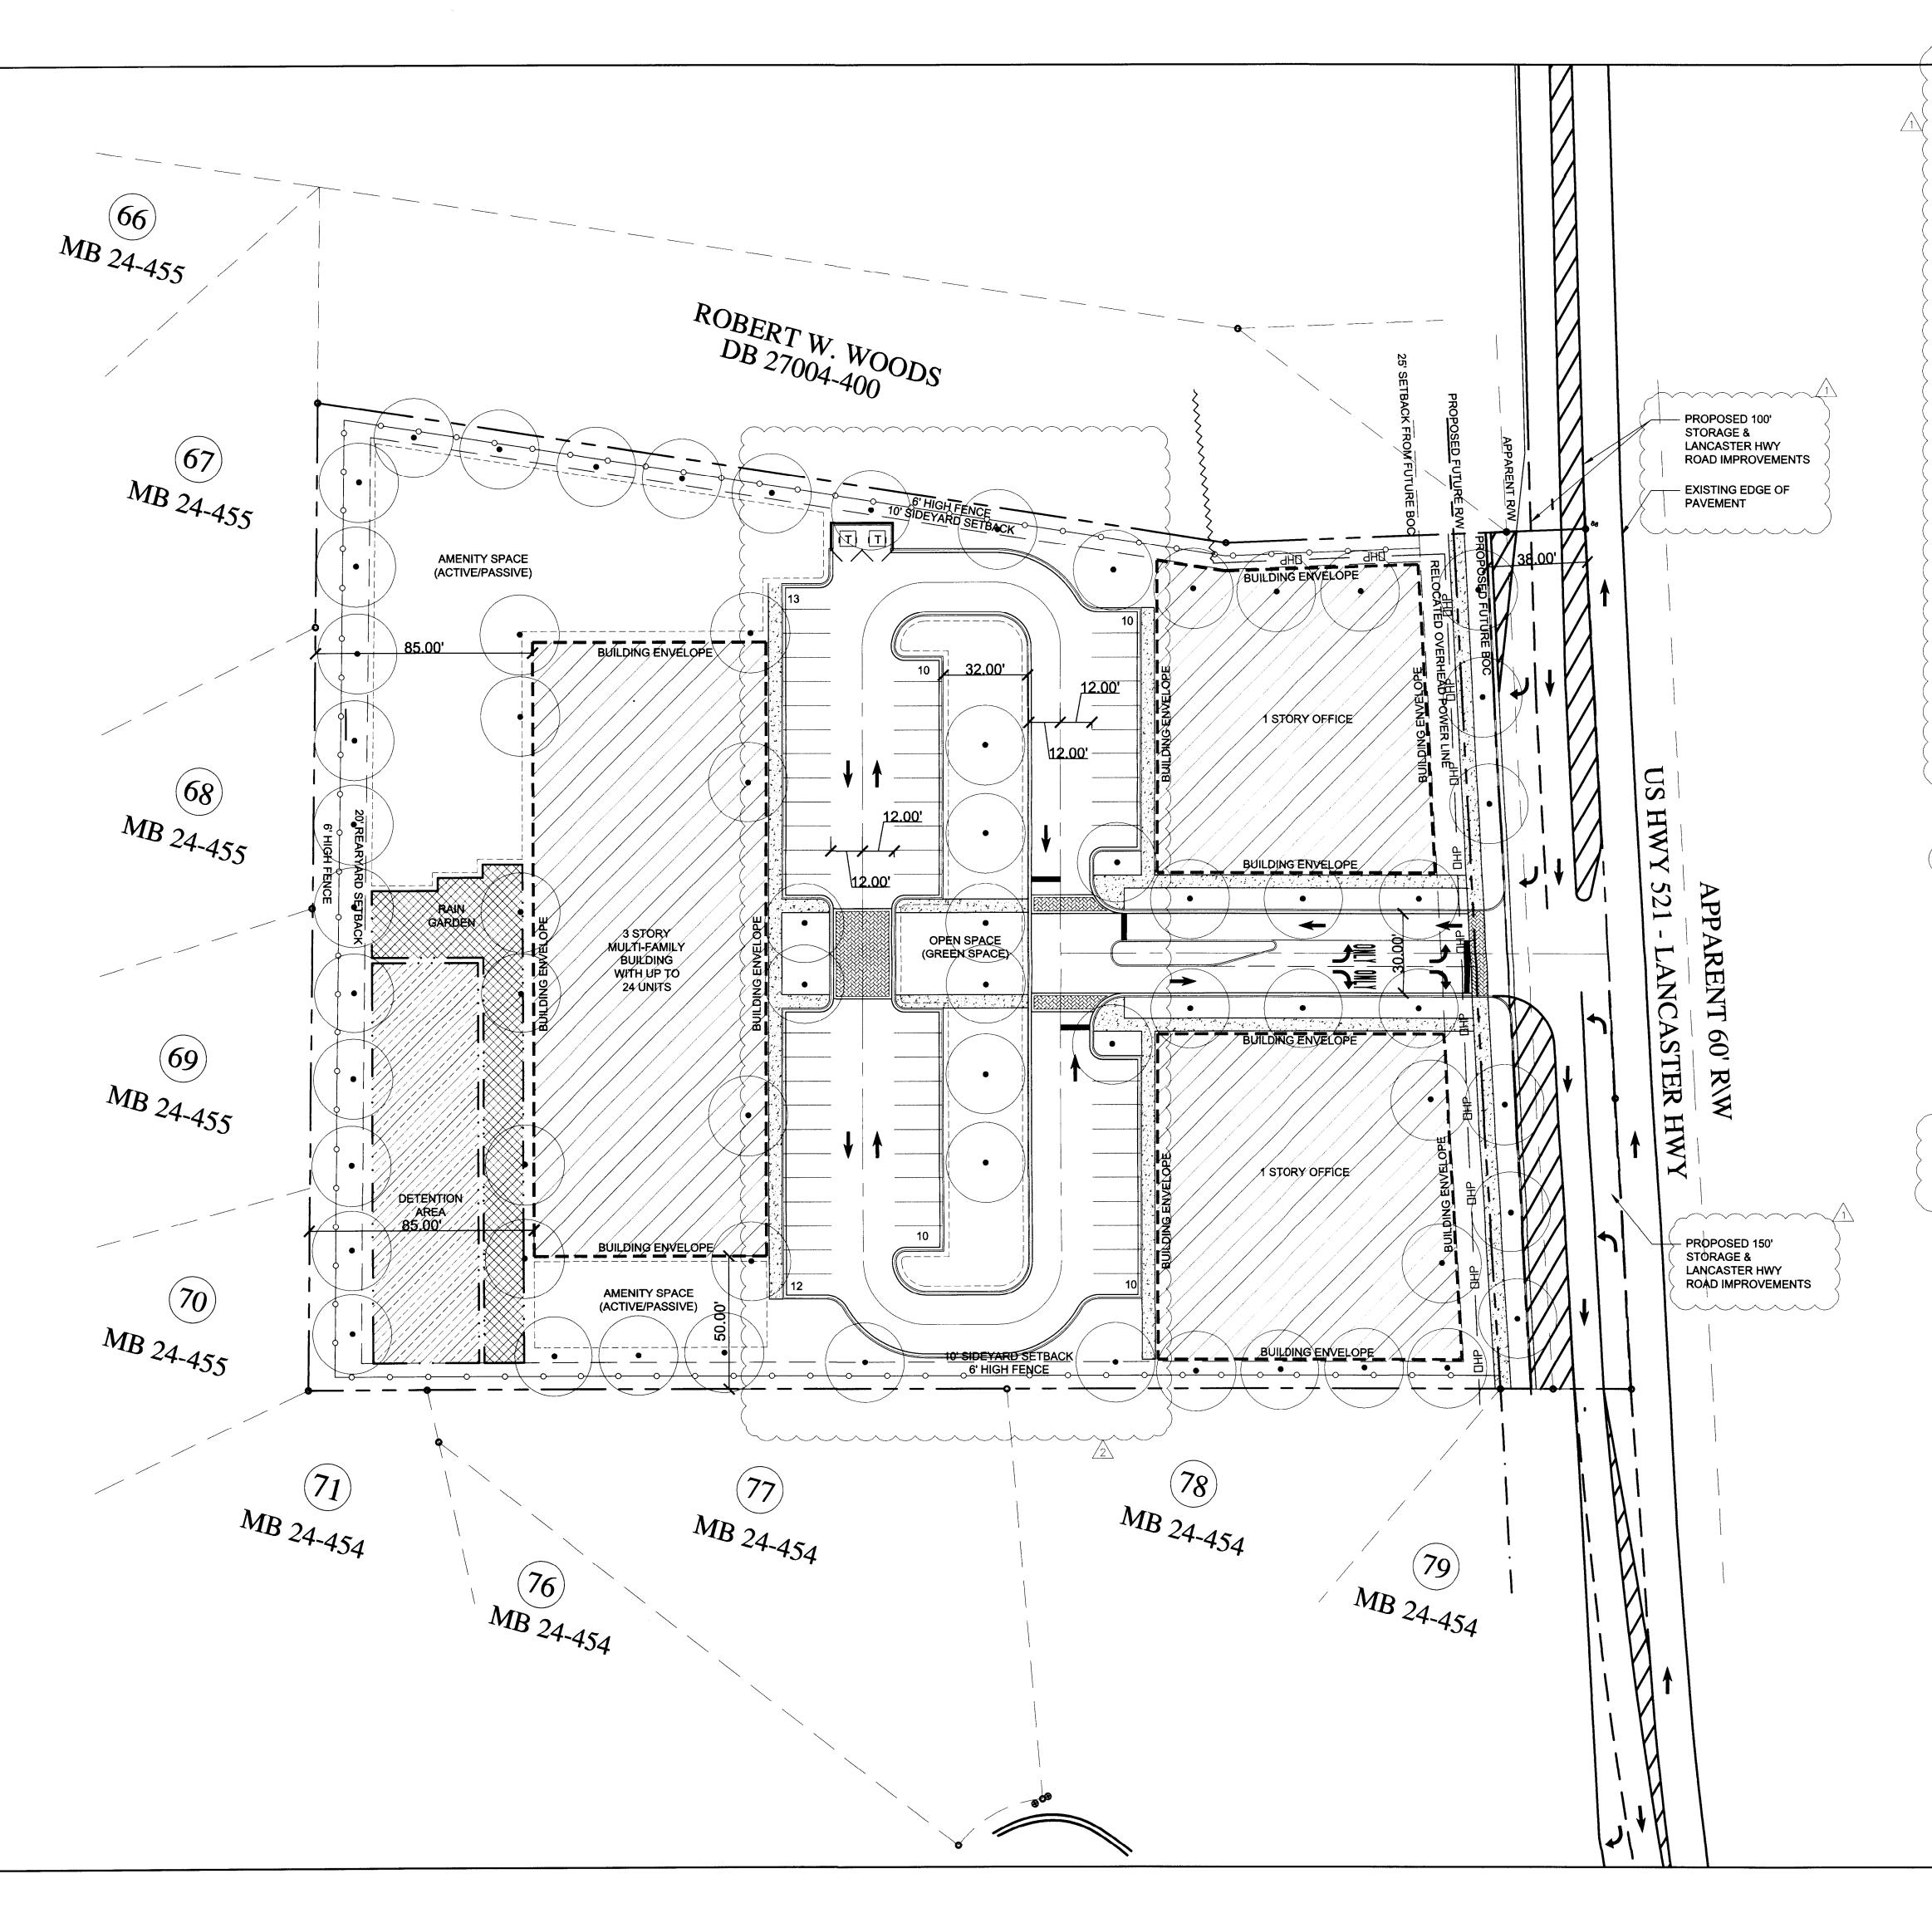

DEVELOPI TAX PARCEL ZONING IURI			
		223-451-81	<u>ج</u>
	ID 5.	MECKLENBURG COUNTY	
TOTAL SITE A		(3.78) 3.62 AC NET OF EXISTING R/W	
REQUIRED P.	ARKING:	42 STALLS (NS DISTRICT)	harlotte, 1332.322
PARKING PR		A MINIMUM OF 1.5 PARKING SPACES	
		PER DWELLING UNIT AND A MINIMUM	am Stre
		OF 1.0 PARKING SPACE FOR EACH 300	23 N Graham S 704.333.0325 ww.LandDesign
		350 GROSS SQUARE FEET OF OFFICE	
7		USE WILL BE PROVIDED.	×
Zoning:			$\left \right\rangle$
EXISTING ZO	NING:	R8-MF(CD)	$\left \right\rangle$
EXISTING US	.E:	SINGLE FAMILY DWELLING UNIT	
		(structure) & vacant land	$\left\{ \right\}$
PROPOSED Z	ONING:	NS (NEIGHBORHOOD SERVICES)	$\left \right\rangle$
PROPOSED U	SE:	UP TO 24 MULTI-FAMILY RESIDENTIAL	
		DWELLING UNITS AND UP TO 10,000	
		SQ.FT. OF GROSS FLOOR AREA OF	
		GENERAL AND MEDICAL OFFICE USE	$\left\{ \right\}$
		TOGETHER WITH ACCESSORY USES, AS	
		ALLOWED IN THE NS ZONING	
		DISTRICT.	$\left\{ \right\}$
	~~~~~		$\left  \right $
FEET FOR TH	E PROPOSED OF	ND NOT TO EXCEED ONE (1) STORY AND 30 FFICE BUILDINGS, BUILDING HEIGHT TO BY THE ORDINANCE.	ASTER HWY PTUAL SITE PLAN PARTMENT GROUP; MECKLENBURG CHARLOTTE REZONING 20
		REES TO BE SAVED TREET TREES	
	Proposed s		
	Proposed s Proposed w	TREET TREES	COMMENTS COMMENTS CONCE SOUTHERN A CITY OF O
	Proposed s Proposed w Proposed f	TREET TREES VATER QUALITY	: LEZONING COMMENTS COMMUNITY COMMENT
	Proposed s Proposed s Proposed f Proposed f Proposed f APPRO BOARD 0	TREET TREES VATER QUALITY AIN GARDEN BLDG ENVELOPE VED BY OF COUNTY SSIONERS	

 

## Site Development Data: 1. Architectural a. The building m -Acreage: $\pm$ 3.62 acres net of existing right-of-way ( $\pm$ 3.78 acres total) of the followin -- Tax Parcel #: 223-451-81 hardi-plank), st -Existing Zoning: R-8MF(CD) (by Rezoning Petition No. 2008-001(c)) only be used or -Proposed Zoning: NS -Existing Uses: A single-family dwelling unit. b. No spans of bla -Proposed Uses: Up to 24 multi-family residential dwelling units and up to 10,000 square feet of gross floor c. The roofs on th area of general and medical office uses together with accessory uses, as allowed in the NS zoning district. d. Meter banks w -Maximum Building Height: Not to exceed (3) stories or 40 feet for the multi-family residential building; and e. HVAC and rel not to exceed one (1) story and 30 feet for the proposed office buildings, building height to be measured as

defined by the Ordinance. --Parking: A minimum of 1.5 parking spaces per dwelling unit and a minimum of 1.0 parking space for each 300 350 gross square feet of office uses will be provided.

- 1. General Provisions:
- a. Site Location. These Development Standards form a part of the Rezoning Plan associated with the Rezoning Petition filed by Southern Apartment Group - Ballantyne, LLC ("Petitioner") to accommodate the development of a 24 unit multi-family community and a small scale professional office park on approximately 3.78 gross acre site (3.62 acres excluding existing road right-of-way) located on the west side of Lancaster Hwy. between Southcrest Lane and Winghurst Drive (the "Site").
- b. Zoning Districts/Ordinance. Development of the Site will be governed by the Rezoning Plan as well as the applicable provisions of the Mecklenburg County Zoning Ordinance (the "Ordinance"). Unless the Rezoning Plan establishes more stringent standards the regulations established under the Ordinance for the NS zoning classification shall govern.
- Graphics and Alterations. The schematic depictions of the uses, parking areas, sidewalks, structures and buildings, building elevations, streets and other development matters and site elements (collectively the "Development/Site Elements") set forth on the Rezoning Plan should be reviewed in conjunction with the provisions of these Development Standards. The layout, locations, sizes and formulations of the Development/Site Elements depicted on the Rezoning Plan are graphic representations of the Development/Site elements proposed. Changes to the Rezoning Plan not anticipated by the Rezoning Plan will be reviewed and approved as allowed by Section 6.207 of the Ordinance.

Since the project has not undergone the design development and construction phases, it is intended that this Rezoning Plan provide for flexibility in allowing some alterations or modifications from the graphic representations of the Development/Site Elements. Therefore, there may be instances where minor modifications will be allowed without requiring the Administrative Amendment Process per Section 6.207 of the Ordinance. These instances would include changes to graphics if they are:

- expressly permitted by the Rezoning Plan (it is understood that if a modification is expressly permitted by the Rezoning Plan it is deemed a minor modification for the purposes of these Development Standards); or,
- minor and don't materially change the overall design intent depicted on the Rezoning Plan; or
- modifications to move structures graphically depicted on the Rezoning Plan closer to adjacent properties in a residential district or abutting residential use but no closer than the "building envelope line" indicated on Sheet RZ-1; or
- modifications to allow changes to the configuration and type of improvements indicated on Sheet RZ-2 to the amenity areas/open spaces as long as the total area of the amenity areas/open spaces is not reduced beyond what is indicated on the Rezoning Plan.

The Planning Director will determine if such minor modifications are allowed per this amended process, and if it is determined that the alteration does not meet the criteria described above, the Petitioner shall then follow the Administrative Amendment Process per Section 6.207 of the Ordinance; in each instance, however, subject to the Petitioner's appeal rights set forth in the Ordinance.

d. Number of Buildings Principal and Accessory. The total number of principal buildings to be developed on the Site shall not exceed four (4). Accessory buildings and structures located on the Site shall not be considered in any limitation on the number of buildings on the Site. Accessory buildings and structures will be constructed utilizing similar building materials, colors, architectural elements and designs as the principal building located on the Site.

## 2. Permitted Uses & Development Area Limitation:

a. The Site may be developed with up to 24 multi-family residential dwellings units and up to 10,000 square feet of gross floor area of general and medical office uses together with accessory uses allowed in the NS zoning district.

b. Surface parking areas will not be allowed between Lancaster Highway and the proposed buildings.

## 3. Access and Transportation:

- a. Access to the Site will be from Lancaster Highway in the manner generally depicted on the Rezoning Plan.
- b. The Petitioner will dedicate in fee-simple to the City of Charlotte up to 50 feet of right-of-way from the center line of Lancaster Highway. This right-of-way dedication will occur prior to the issuance of a certificate of occupancy for the building constructed on the Site.

c. The Petitioner will install curb gutter and sidewalk in the location generally indicated on the Rezoning Plan.

- d. c. The placement and configuration of the vehicular access point is subject to any minor modifications required to accommodate final site development and construction plans and to any adjustments required for approval by the CDOT or NCDOT in accordance with applicable published standards.
- e. d. The alignment of the internal vehicular circulation and driveways may be modified by the Petitioner to accommodate changes in traffic patterns, parking layouts and any adjustments required for approval by CDOT in accordance with published standards. ~~~~~~

properties at gr

Dumpster areas gate. The wall materials and c areas is general

## Streetscape, B

Along Lancaste Lancaster High

A five (5)10 fo along the Site's buffer will be e _____ The Petitioner c. Rezoning Plan.

space areas will of the Site. Utilities may cr

The Petitioner frontage on Lar

The Petitioner Lancaster High sidewalk will b

Screening requi

Above ground required setbac

6. Environmenta

The Petitioner Ordinance.

The location, si review and app rezoning. Ad requirements an

7. Signage:

Signage as allo a.

8. Lighting:

All new lightin a. installed along

Detached lighti

9. Amendments

a. Future amend by the then Ov

amendment in

- 10. Binding Effect
- a. If this Rezonin the Rezoning I inure to the bei personal repres

Standards:	
naterials used on the principal buildings constructed on Site will be a combination of portions ng: brick, stone, precast stone, precast concrete, synthetic stone, cementatious siding (such as tucco, EIFS, decorative block and/or wood. Vinyl or aluminum as a building material may n windows, soffits and on handrails/railings.	esign arbtte, NC 28202 332.3246
ank, unarticulated walls greater than 20 feet will be allowed along Lancaster Highway.	្រ 🗖 ប័ន្ន
the buildings will be constructed utilizing architectural shingles.	<b>LiandDD</b> 223 N Graham Street Chan V: 704.333.0325 F: 704.3 www.LandDesign.com
ill be screened from adjoining properties and from Lancaster Highway.	Graham 333.037 ndDesi
lated mechanical equipment will be screened from public view and from view of adjacent rade.	23 N G
s and recycling areas will be enclosed by a solid wall or fence with one side being a decorative l or fence used to enclose the dumpster will be architecturally compatible with the building colors used on the principal building. The location of the proposed dumpster and recycling lly depicted on the Rezoning Plan.	
Suffers, Open Space, Yards and Landscaping:	
er Highway a <del>14</del> -25 foot setback measured from the back of the future <del>right-of-way line of rway</del> curb will be provided as generally depicted on the Rezoning Plan.	
oot vegetative screen Class C Buffer with a decorative solid six (6) foot fence will be provided is perimeter as generally depicted on the Rezoning Plan. The trees planted within the Class C evergreen trees and will be a minimum of eight (8) feet tall at installation.	D D
has identified on the Rezoning Plan several open space areas as generally depicted on the . These open space areas may include existing trees as well as new landscaping. These open ll be improved with seating areas landscaping and other features for the residents and tenants	
will provide a five six (56) foot sidewalk and an eight (8) planting strip as along the Site's neaster Highway Road in the manner generally depicted on the Rezoning Plan.	<u></u>
will provide a sidewalk network that connects the buildings on the Site to the sidewalk along hway in the manner depicted on the Rezoning Plan. The minimum width for this internal be five (5) feet.	
irements of the Ordinance will be met.	
backflow preventers will be screened from public view and will be located outside of the eks.	
al Features:	
shall comply with the Mecklenburg County approved and adopted Post Construction Controls	⊆
ize and type of storm water management systems depicted on the Rezoning Plan are subject to proval as part of the full development plan submittal and are not implicitly approved with this djustments may be necessary in order to accommodate actual storm water treatment nd natural site discharge points.	IBURG COUNTY G 2014-001(C)
wed by the Ordinance will be provided.	ACASTER HWY HNICAL DATA SHEET IERN APARTMENT GROUP; MECKLENBL OF CHARLOTTE REZONING
ng shall be full cut-off type lighting fixtures excluding lower, decorative lighting that may be the driveways, sidewalks, and parking areas.	
ing on the Site will be limited to 15 feet in height.	OT NO N
to the Rezoning Plan:	
nents to the Rezoning Plan (which includes these Development Standards) may be applied for wner or Owners of the applicable Development Area portion of the Site affected by such accordance with the provisions of Chapter 6 of the Ordinance.	
t of the Rezoning Application:	
ng Petition is approved, all conditions applicable to the development of the Site imposed under Plan will, unless amended in the manner provided under the Ordinance, be binding upon and nefit of the Petitioner and subsequent owners of the Site and their respective heirs, devisees, sentatives, successors in interest or assigns.	
APPROVED BY BOARD OF COUNTY COMMISSIONERS FEB - 3 2015	<b>REVISIONS:</b> 09/12/14 - REZONING COMMENTS 11/20/14 - COMMUNITY COMMENTS
PETITION #: 2014-001(C) CITY OF CHARLOTTE	DATE: 06.23.14 DESIGNED BY: LDB DRAWN BY: LDB CHECKED BY: MB Q.C. BY: MB Q.C. BY: MB SCALE: PER SHEET PROJECT #: 1013226 SHEET #: SHEET #:


# PROPOSED OFFICE ELEVATION





NOTE: THESE ELEVATIONS ARE PROVIDED TO REFLECT THE ARCHITECTURAL STYLE AND QUALITY OF THE BUILDINGS THAT MAY BE CONSTRUCTED ON THE SITE (THE ACTUAL BUILDINGS CONSTRUCTED ON THE SITE MAY VARY FROM THESE ILLUSTRATIONS AS LONG AS THE GENERAL ARCHITECTURAL CONCEPTS AND INTENT ILLUSTRATED IS MAINTAINED).



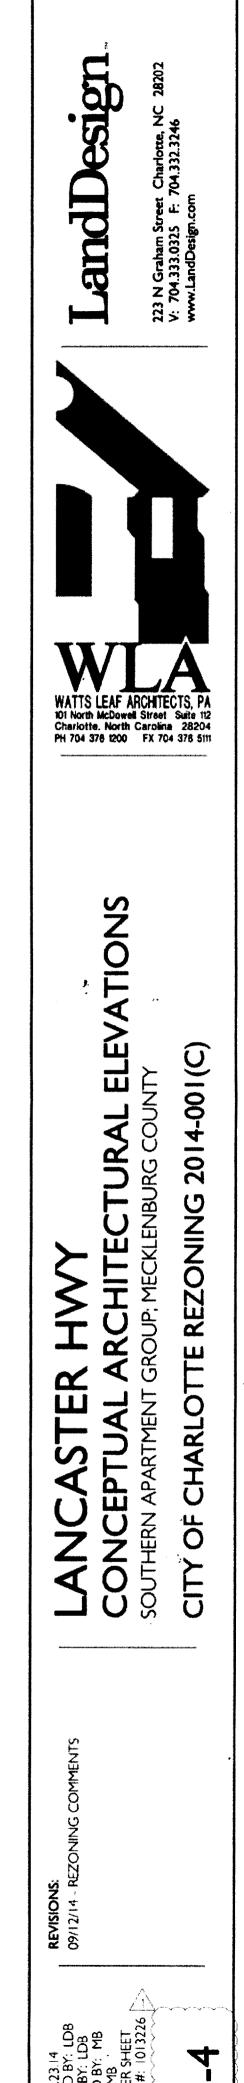

DATE

1

PETITION #: 2014-001(C) CITY OF CHARLOTTE